

MAY 28 2000

KENT COUNTY REMONUMENTATION

\$7.00
\$2.00

SECTION

LAND CORNER RECORDATION CERTIFICATE
Filing Requirement of Act 74, Mich. P.A. 1970

For corners in

KENT COUNTY

(County)

Located In:

Corner Code #

Tyrone Twp.

1. Public Land Survey

T10N R 12W

I-7

2. Property Controlling in Section

S

T

3. Miscellaneous Property in Sec.

S

T

4. Lot No. _____, Recorded Plat _____
5. Private Claims _____

I, Kirk Breitels, in a field survey on Jan. 22, 1999 do hereby state that under requirements of P.A. 74, Michigan P.A. of 1970, the corner points mentioned in lines 1 and 2 above were in conformance with regulations and rules therefore as required in the current manual of survey instructions of the United States Department of the Interior, Bureau of Land Management or by a decree of a Court of Law and/or that the corner points mentioned in lines 3, 4 and 5 above were in conformance with the rules of the Michigan Board of Land Surveyors or by a Decree of a Court of Law; established, re-established, monumented, recovered, found as expressed below:

NOTE: Not more than 2 corners, all in the same town and range, may be recorded on this certificate.

A. Description of original monument and accessories and/or subsequent restoration:

I-7	1837	GLO	Whitcomb	Set Post
	1964	Kent Co. Wits		Iron & Stone
	1981	LCRC #1624	Glaza	RR Spike
	1982	LCRC #3023	Starr	Set Kent County Monument
	1991	LCRC #6008	Byl	Kent County Monument

P.A. 345 1990 KENT COUNTY
PEER APPROVED 2/25/99
CHAIRMAN *[Signature]*

The position of this corner was previously approved by the Kent County Remonumentation Peer Group, monumented by Thomas C. Starr on 8-2-82 and was recorded per LCRC #3023.

B. Description of corner evidence found and/or method applied in restoring or reestablishing corner:

I-7 Found Kent County Monument (Harrison) per witnesses from above LCRC as set by Thomas C. Starr in place of the RR Spike over a 2" Iron he found. Both Irons check with Kent Co. Wit. and LCRC #1624.

LCRC #3023	Nail & Remon. tag 14" Maple	S40°W 67.70'	LCRC #6008	Nail & Remon. tag 16" Maple	S40°W 67.70'
	Nail & Remon. tag 10" Oak	S60°W 67.40'		Nail & Remon. tag 12" Oak	S60°W 67.40'
	Nail & Remon. tag 16" Tw. Oak	S80°W 126.83'		Nail & Remon. tag 18" Tw. Oak	S80°W 125.83'
	Nail & Remon. tag 12" Pine	N30°W 89.38'		Nail & Remon. tag 14" Pine	N30°W 89.38'
	Nail & Remon. tag P. Pole	N30°E 70.77'		Nail & Remon. tag P. Pole	N30°E 71.06'
	Nail & Remon. tag Tw. 12" Maple	S85°E 24.04'		Nail & Remon. tag Tw. 12" Maple	S85°E 24.04'

The selected location is accepted by me and is generally accepted by professional surveyors as the best available evidence of the position of the original corner.


C. Description of monument for corner and accessories established to perpetuate locating the position of the corner:

I-7 Standard Kent County Monument		
Nail & KC Remon. tag S. side 18" Maple	S40°W	67.63'
Nail & KC Remon. tag N. side 16" Oak	S60°W	67.30'
Nail & KC Remon. tag N. side Twin 18" Oak	S80°W	126.80'
Nail & KC Remon. tag E. side 18" Pine	N30°W	89.32'
Nail & KC Remon. tag W. side P. Pole	N30°E	71.17'
Nail & KC Remon. tag N. side Twin 14" Maple	S85°E	24.01'
3' E. & 4' N. of C/L "X" of gravel roads N-S & W		



Signed by *[Signature]*
Surveyor's Michigan License No. 30077

Date 2/25/99

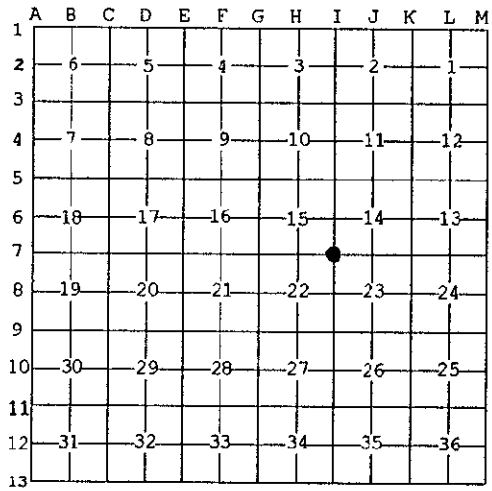

STATE OF MICHIGAN
COUNTY OF KENT
RECEIVED FOR RECORD
1999 MAR 24 AM 9:02
NEG. OF DEEDS
11174
Register of Deeds Stamp & File Number