

\$7.00
\$2.00

MAY 22 2000

KENT COUNTY REMONUMENTATION

LAND CORNER RECORDATION CERTIFICATE Filing Requirement of Act 74, Mich. P.A. 1970

STATE OF MICHIGAN
COUNTY OF KENT
RECEIVED FOR RECORD
1999 MAR 24 AM 8:03

REG. OF DEEDS
[Signature]

For corners in SECTION

KENT COUNTY
(County)

Located in:

Corner Code #

| | | |
|------------------------------------|------------|---------------------|
| 1. Public Land Survey | T10N R 12W | Tyrone Twp. J-11 |
| | T R | |
| | T R | |
| | T R | |
| 2. Property Controlling in Section | S T R | |
| | S T R | |
| 3. Miscellaneous Property in Sec. | S T R | |
| | S T R | |


11183

Register of Deeds Stamp & File Number

4. Lot No. _____, Recorded Plat _____
5. Private Claims _____

I, Kirk Breitels, in a field survey on Jan. 26, 1999 do hereby state that under requirements of P.A. 74, Michigan P.A. of 1970, the corner points mentioned in lines 1 and 2 above were in conformance with regulations and rules therefore as required in the current manual of survey instructions of the United States Department of the Interior, Bureau of Land Management or by a decree of a Court of Law and for that the corner points mentioned in lines 3, 4 and 5 above were in conformance with the rules of the Michigan Board of Land Surveyors or by a Decree of a Court of Law; established, re-established, monumented, recovered, found as expressed below:

NOTE: Not more than 2 corners, all in the same town and range, may be recorded on this certificate.

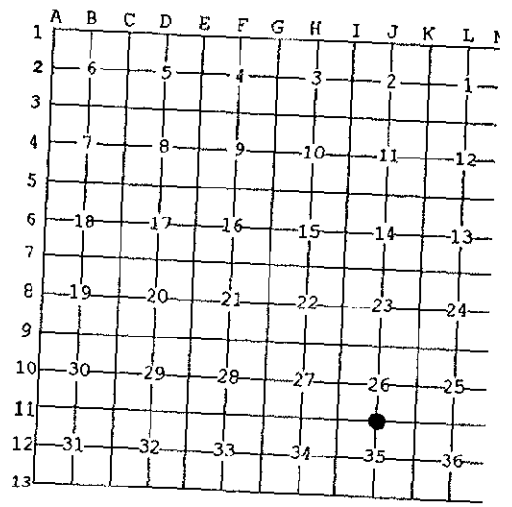

A. Description of original monument and accessories and/or subsequent restoration:

| | | | |
|-----------|---------------|------------|---|
| J-11 1837 | GLO | Whitcomb | Set Post |
| 1938 | Kent Co. Wits | | Iron and Stone |
| 1972 | LCRC #143 | N.C. Jones | 1" Pipe in Mon. Box |
| 1983 | LCRC #3430 | Bueche | Set Kent County Monument in Mon. Box |
| 1991 | LCRC #6019 | Byl | Kent County Monument in Mon. Box |
| 1995 | LCRC #8751 | Breitels | Reset Kent County Monument in Mon. Box after construction |

The position of this corner was previously approved by the Kent County Remonumentation Peer Group, monumented by John C. Bueche on 5-17-83 and was recorded per LCRC #3430.

P.A. 345 1990 KENT COUNTY
PEER APPROVED 2/25/99
CHAIRMAN [Signature]

B. Description of corner evidence found and/or method applied in restoring or reestablishing corner:

J-11 Found Kent County Monument (Harrison) per witnesses from above LCRC as reset by Kirk Breitels in the same location as set by John C. Bueche in place of the 1" Iron he found over a Pointed Stone inside a Mon. Box. Both Iron and Stone check with Kent Co. Wits. and LCRC #143.

| | | | | |
|------------|--------------------------------|---------------|---|---------------|
| LCRC #3430 | Nail & Remon. tag 10" Pine | S40°W 44.97' | LCRC #6019 & #8751 (witnesses the same) | |
| | Nail & Remon. tag P. Pole | N25°W 66.67' | Nail & Remon. tag P. Pole | N25°W 66.67' |
| | Nail & Remon. tag P. Pole | N45°E 75.66' | Nail & Remon. tag P. Pole | N45°E 75.58' |
| | Nail & Remon. tag dbl. 28" Oak | S10°W 101.85' | Nail & Remon. tag dbl. 32" Oak | S10°W 101.82' |
| | Nail & Remon. tag P. Pole | S30°E 94.40' | Nail & Remon. tag P. Pole | S30°E 94.40' |
| | Nail & Remon. tag 12" Pine | S55°W 61.83' | Nail & Remon. tag 12" Pine | S55°W 61.83' |

The selected location is accepted by me and is generally accepted by professional surveyors as the best available evidence of the position of the original corner.

C. Description of monument for corner and accessories established to perpetuate locating the position of the corner:

J-11 Standard Kent County Monument in Mon. Box

| | |
|---|---------------|
| Nail & KC Remon. tag W. side P. Pole | N25°W 66.67' |
| Nail & KC Remon. tag SW side P. Pole | N45°E 75.58' |
| Nail & KC Remon. tag E. side dbl. 34" Oak | S10°W 101.82' |
| Nail & KC Remon. tag NE side P. Pole | S30°E 94.40' |
| Nail & KC Remon. tag NW side 12" Pine | S55°W 61.83' |

On C/L E-W-N asphalt roads



Signed by [Signature]
Surveyor's Michigan License No. 30077

Date 2/25/99