

\$7.00  
\$2.00

JAN 28 2000

SECTION

# KENT COUNTY REMONUMENTATION

## LAND CORNER RECORDATION CERTIFICATE Filing Requirement of Act 74, Mich. P.A. 1970

REG. OF DEEDS

*[Signature]*

STATE OF MICHIGAN  
COUNTY OF KENT  
RECEIVED FOR RECORD  
1999 MAR 24 AM 8:03

For corners in

KENT COUNTY (County)	Located In:	Corner Code #
1. Public Land Survey	T <u>10</u> N R <u>12</u> W	<u>K-5</u>
	T ___ R ___	___
	T ___ R ___	___
	T ___ R ___	___
2. Property Controlling in Section	S ___ T ___ R ___	___
	S ___ T ___ R ___	___
3. Miscellaneous Property in Sec.	S ___ T ___ R ___	___
	S ___ T ___ R ___	___


11187

Register of Deeds Stamp & File Number

4. Lot No. \_\_\_\_\_, Recorded Plat \_\_\_\_\_  
5. Private Claims \_\_\_\_\_

I, Kirk Breitels, in a field survey on Jan. 15, 19 99 do hereby state that under requirements of P.A. 74, Michigan P.A. of 1970, the corner points mentioned in lines 1 and 2 above were in conformance with regulations and rules therefore as required in the current manual of survey instructions of the United States Department of the Interior, Bureau of Land Management or by a decree of a Court of Law and /or that the corner points mentioned in lines 3, 4 and 5 above were in conformance with the rules of the Michigan Board of Land Surveyors or by a Decree of a Court of Law; established, re-established, monumented, recovered, found as expressed below:

NOTE: Not more than 2 corners, all in the same town and range, may be recorded on this certificate.

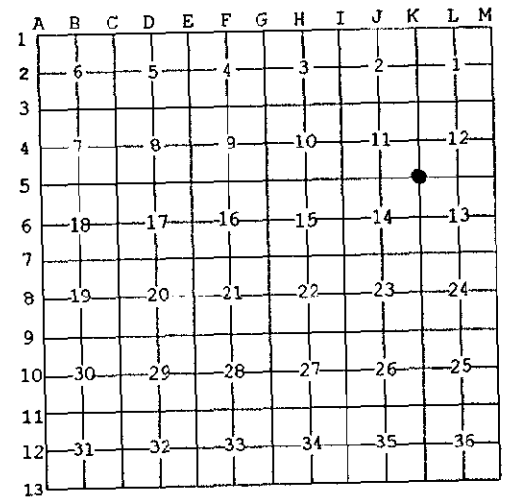

### A. Description of original monument and accessories and/or subsequent restoration:

K-5 1837	GLO	Whitcomb	Set Post
1965	Kent Co. Wits		Boat Spike
1979	LCRC #1247	Wickham	1" Iron in Mon. Box
1983	LCRC #3439	Bueche	Set Kent County Monument in Mon. Box
1985	LCRC #4194	Brintnall	Kent County Monument
1991	LCRC #6025	Byl	Kent County Monument

The position of this corner was previously approved by the Kent County Remonumentation Peer Group, monumented by John C. Bueche on 5-24-83 and was recorded per LCRC #3439.

P.A. 345 1990 KENT COUNTY  
PEER APPROVED 2/25/99  
CHAIRMAN [Signature]

### B. Description of corner evidence found and/or method applied in restoring or reestablishing corner:

K-5 Found Kent County Monument (Harrison) per witnesses from above LCRC as set by John C. Bueche in place of the Iron he found in a Mon. Box. Said Iron checks with Kent Co. Wits. and LCRC #3439.

LCRC #3439	LCRC #4194	LCRC #6025
P. Pole N60°E 54.29'	NE 54.31' P. Pole	P. Pole N60°E 54.26'
24" Oak S25°E 66.02'	SE 66.03' 18" Oak	24" Oak S25°E 65.83'
16" Pine N15°W 111.05'	SSW 132.73' 19" Pine	18" Pine N15°W 111.01'
14" Pine N15°E 136.53'	NW 66.78' 28" Maple	16" Pine N15°E 136.45'
38" Maple N45°W 66.76'		30" Maple N45°W 66.70'
18" Pine S15°W 132.73'		24" Pine S15°W 132.65'

The selected location is accepted by me and is generally accepted by professional surveyors as the best available evidence of the position of the original corner.

### C. Description of monument for corner and accessories established to perpetuate locating the position of the corner:

K-5 Standard Kent County Monument in Mon. Box			
Nail & KC Remon. tag NW side P. Pole	N60°E	54.28'	
Nail & KC Remon. tag NE side 28" Oak	S25°E	65.83'	
Nail & KC Remon. tag E. side 20" Pine	N15°W	111.05'	
Nail & KC Remon. tag W. side 18" Pine	N15°E	136.50'	
Nail & KC Remon. tag NE side 32" Maple	N45°W	66.73'	
Nail & KC Remon. tag W. side 26" Pine	S15°W	132.65'	



Signed by *[Signature]*  
Surveyor's Michigan License No. 30077

Date 2/25/99