

SECTION

KENT COUNTY REMONUMENTATION

LAND CORNER RECORDATION CERTIFICATE
Filing Requirement of Act 74, Mich. P.A. 1970

For corners in

KENT COUNTY
(County)

Located In:

Corner Code #

Tyrone Twp.

1. Public Land Survey

T10N R12W

L-6

T R

T R

T R

T R

2. Property Controlling in Section

S

T R

S

T R

3. Miscellaneous Property in Sec.

S

T R

S

T R

REG. OF DEEDS

[Signature]

STATE OF MICHIGAN
COUNTY OF KENT
RECEIVED FOR RECORD
1999 MAR 24 AM 8:03

11196

Register of Deeds Stamp & File Number

4. Lot No. , Recorded Plat
5. Private Claims


I, Kirk Breitels, in a field survey on Feb. 18, 1999 do hereby state that under requirements of P.A. 74, Michigan P.A. of 1970, the corner points mentioned in lines 1 and 2 above were in conformance with regulations and rules therefore as required in the current manual of survey instructions of the United States Department of the Interior, Bureau of Land Management or by a decree of a Court of Law and/or that the corner points mentioned in lines 3, 4 and 5 above were in conformance with the rules of the Michigan Board of Land Surveyors or by a Decree of a Court of Law; established, re-established, monumented, recovered, found as expressed below:

NOTE: Not more than 2 corners, all in the same town and range, may be recorded on this certificate.

A. Description of original monument and accessories and/or subsequent restoration:

Table with columns: Year, Monument Type, Location, Description. Includes entries for 1837, 1979, and 1991.

P.A. 345 1990 KENT COUNTY
PEER APPROVED 2/25/99
CHAIRMAN [Signature]

The position of this corner was previously approved by the Kent County Remonumentation Peer Group, monumented by John C. Bueche on 6-13-91 and was recorded per LCRC #5862.

B. Description of corner evidence found and/or method applied in restoring or reestablishing corner:


L-6 Found Kent County Monument (Harrison) per witnesses from above LCRC as set by John C. Bueche at the intersection of 1/4 lines. Concrete Monument per LCRC #1248 was incorrect.

Table with columns: Evidence Type, Direction, Distance. Includes Concrete Monument, Nail & Remon. tag E. side 24" Oak, etc.

The selected location is accepted by me and is generally accepted by professional surveyors as the best available evidence of the position of the corner.

C. Description of monument for corner and accessories established to perpetuate locating the position of the corner:

Table with columns: Monument Type, Direction, Distance. Includes Standard Kent County Monument, Concrete Monument, Nail & KC Remon. tag E. side 26" Oak, etc.

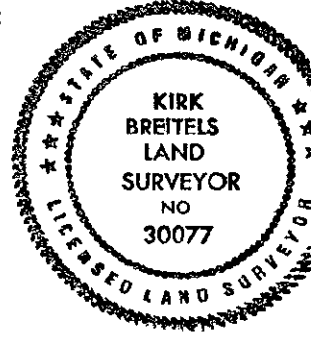

Signed by [Signature]
Surveyor's Michigan License No. 30077

Date 2/25/99