

MAY 22 2000

KENT COUNTY REMONUMENTATION

LAND CORNER RECORDATION CERTIFICATE  
Filing Requirement of Act 74, Mich. P.A. 1970

SECTION

For corners in

KENT COUNTY  
(County)

Located In:

Corner Code #

Tyrone Twp.

1. Public Land Survey

T 10N R 12W

L-12

T	R	
T	R	
T	R	
T	R	
S	T	R
S	T	R
S	T	R
S	T	R

2. Property Controlling in Section

3. Miscellaneous Property in Sec.

REG. OF DEEDS

1999 DEC 15 AM 8:57

STATE OF MICHIGAN  
COUNTY OF KENT  
RECEIVED FOR RECORD

11614

Register of Deeds Stamp & File Number

4. Lot No. \_\_\_\_\_, Recorded Plat \_\_\_\_\_  
5. Private Claims \_\_\_\_\_

I, Kirk Breitels, in a field survey on Nov. 19, 1999 do hereby state that under requirements of P.A. 74, Michigan P.A. of 1970, the corner points mentioned in lines 1 and 2 above were in conformance with regulations and rules therefore as required in the current manual of survey instructions of the United States Department of the Interior, Bureau of Land Management or by a decree of a Court of Law and /or that the corner points mentioned in lines 3, 4 and 5 above were in conformance with the rules of the Michigan Board of Land Surveyors or by a Decree of a Court of Law; established, re-established, monumented, recovered, found as expressed below:

NOTE: Not more than 2 corners, all in the same town and range, may be recorded on this certificate.

	A	B	C	D	E	F	G	H	I	J	K	L	M
1													
2		6		5		4		3		2		1	
3													
4		7		8		9		10		11		12	
5													
6		10		17		16		15		14		13	
7													
8		19		20		21		22		23		24	
9													
10		30		29		28		27		26		25	
11													
12		31		32		33		34		35		36	
13													

A. Description of original monument and accessories and/or subsequent restoration:

L-12 1837 GLO	Not Set
Williams & Works	No information
Kent Co. Wits	No information

P.A. 345 1990 KENT COUNTY  
PEER APPROVED 12/02/99  
CHAIRMAN Harry Huber

B. Description of corner evidence found and/or method applied in restoring or reestablishing corner:


L-12 Found nothing at corner - corner falls in swampy area. Established position of corner per information by All Points Surveyor's Inc. site condominium "Rogue River Pines," (Liber 3441, Page 1087). Said site condominium is an extension and continuation of prior surveys by Jonker and Nederveld & Assoc. Per site condominium, the Center of Sec. 36 is the Southwest corner of said condominium and is 496.00' West (along E-W 1/4 line) of the Southeast corner of said site condominium. Found a Concrete Monument at the Southeast corner of said site condominium and extended a line from the East 1/4 corner through the Concrete Monument and 496.00' West for Center of Sec. 36. Computations for this Center of Section agree ± with measurements of Jonker and Nederveld & Assoc. This position is 1.1' South and 1.8' East of the intersection of 1/4 lines.

The location described above is accepted by me and is generally accepted by professional surveyors as the best available evidence of the position of the corner.

C. Description of monument for corner and accessories established to perpetuate locating the position of the corner:

L-12 Set 3/4" x 60" Iron Pipe with yellow "Kent Co. Remon." cap at location described above.

Nail & KC Remon. tag N. side 30" Oak	S75°E	67.98'
Nail & KC Remon. tag W. side 18" Oak	S30°E	60.92'
Nail & KC Remon. tag NW side 15" Poplar	S25°W	63.79'
Nail & KC Remon. tag S. side 12" Oak	N75°W	14.68'
Nail & KC Remon. tag E. side 18" Maple	North	12.52'
Concrete Monument	East	496.00'
South edge of swamp is South 50' ±		
Remains of East-West fence is North 12'		

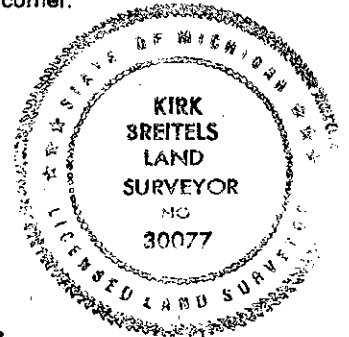

Signed by [Signature]  
Surveyor's Michigan License No. 30077

Date 12/16/99