$7.00
$2.00

MAY 22 2000

SECTION

KENT COUNTY REMONUMENTATION

LAND CORNER RECORDATION CERTIFICATE
Filing Requirement of Act 74, Mich. P.A. 1970

STATE OF MICHIGAN
COUNTY OF KENT
RECEIVED FOR RECORD
1999 MAR 24 AM 8:03
REG. OF DEEDS

11201
Register of Deeds Stamp & File Number

For corners in
KENT COUNTY
(County)

	Located In:		Corner Code #
1. Public Land Survey		T 10N R 12W	Tyrone Twp. M-3
		T___ R___	Common with
		~~T 10N R 11W~~	~~A-3 Solon~~
		T___ R___	
2. Property Controlling in Section	S___	T___ R___	
	S___	T___ R___	
3. Miscellaneous Property in Sec.	S___	T___ R___	
	S___	T___ R___	

4. Lot No. _____ , Recorded Plat _____
5. Private Claims _____

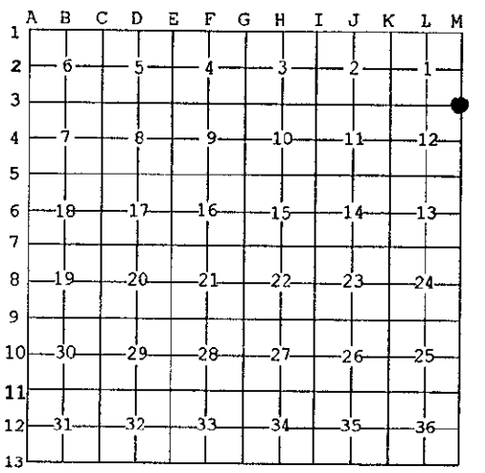

I, Kirk Breitels, in a field survey on Jan. 21, 19 99 do hereby state that under requirements of P.A. 74, Michigan P.A. of 1970, the corner points mentioned in lines 1 and 2 above were in conformance with regulations and rules therefore as required in the current manual of survey instructions of the United States Department of the Interior, Bureau of Land Management or by a decree of a Court of Law and /or that the corner points mentioned in lines 3, 4 and 5 above were in conformance with the rules of the Michigan Board of Land Surveyors or by a Decree of a Court of Law; established, re-established, monumented, recovered, found as expressed below:

NOTE: Not more than 2 corners, all in the same town and range, may be recorded on this certificate.

A. Description of original monument and accessories and/or subsequent restoration:

M-3 1837	GLO	Brookfield	Set Post
1938	Kent Co. Wits		Square Iron
1986	LCRC #4450	Kolehouse	Set Kent County Monument
1991	LCRC #5734	Bueche	Kent County Monument
1991	LCRC #6039	Byl	Kent County Monument

P.A. 345 1990 KENT COUNTY
PEER APPROVED 12/25/99
CHAIRMAN Harry Fuller

The position of this corner was previously approved by the Kent County Remonumentation Peer Group, monumented by Randy J. Kolehouse on 4-5-86 and was recorded per LCRC #4450.

B. Description of corner evidence found and/or method applied in restoring or reestablishing corner:

M-3 Found Kent County Monument (Harrison) per witnesses from above LCRC as set by Randy J. Kolehouse in place of the 1" Iron Pipe he found. Said Iron Pipe checks with Kent Co. Wit.

LCRC #4450 & #5734		LCRC #6039	
Nail & Remon. tag Tw. 16" Oak	S40°W 19.18'	Nail & Remon. tag Tw. 18" Oak	S40°W 19.10'
Nail & Remon. tag 6" Hickory	S10°E 12.91'	Nail & Remon. tag 8" Hickory	S10°E 12.89'
Nail & Remon. tag P. Pole	N40°E 48.89'	Nail & Remon. tag P. Pole	N40°E 48.87'
"X" on Large Stone	N15°W 23.70'	"X" in top of Large Stone	N15°W 23.67'
1" x ½" Iron	North 3.5'	Nail & Remon. tag 8" Poplar	S55°E 49.72'

The selected location is accepted by me and is generally accepted by professional surveyors as the best available evidence of the position of the original corner.

C. Description of monument for corner and accessories established to perpetuate locating the position of the corner:

M-3 Standard Kent County Monument

Nail & KC Remon. tag NW side Twin 20" Oak	S40°W 19.10'
Nail & KC Remon. tag E. side 8" Hickory	S10°E 12.89'
Nail & KC Remon. tag NW side P. Pole	N40°E 48.89'
"X" on top of Large Stone	N15°W 23.70'
Nail & KC Remon. tag N. side 12" Poplar	S55°E 49.78'
½" x 1" Iron Bar	North 3.30'
C/L E-W gravel road is North 2' ±	

STATE OF MICHIGAN
KIRK BREITELS
LAND SURVEYOR
NO 30077
LICENSED LAND SURVEYOR

Signed by Kirk Breitels
Surveyor's Michigan License No. 30077
Date 2/25/99

FORM APPROVED BY MICHIGAN STATE BOARD OF PROFESSIONAL SURVEYORS, JAN. 28, 1971
REVISED MAY 14,1975
REVISED JAN., 1983
REVISED OCT., 1995