

1997 2 2 2099

\$7.00
\$2.00

SECTION

KENT COUNTY REMONUMENTATION

LAND CORNER RECORDATION CERTIFICATE
Filing Requirement of Act 74, Mich. P.A. 1970

For corners in

KENT COUNTY
(County)

Located In: Corner Code #

- 1. Public Land Survey
T 10N R 12W M-5 Tyrone Twp.
T R Common
~~T 10N R 11W A-5 Solon Twp.~~
T R
- 2. Property Controlling in Section
S T R
- 3. Miscellaneous Property in Sec.
S T R
S T R

- 4. Lot No. _____, Recorded Plat _____
- 5. Private Claims _____

I, Kirk Breitels, in a field survey on Jan. 18, 19 99 do hereby state that under requirements of P.A. 74, Michigan P.A. of 1970, the corner points mentioned in lines 1 and 2 above were in conformance with regulations and rules therefore as required in the current manual of survey instructions of the United States Department of the Interior, Bureau of Land Management or by a decree of a Court of Law and /or that the corner points mentioned in lines 3, 4 and 5 above were in conformance with the rules of the Michigan Board of Land Surveyors or by a Decree of a Court of Law; established, re-established, monumented, recovered, found as expressed below:

NOTE: Not more than 2 corners, all in the same town and range, may be recorded on this certificate.

A. Description of original monument and accessories and/or subsequent restoration:

M-5 1837	GLO	Brookfield	Set Post
1965	Kent Co. Wits		1" Iron
1974	LCRC #717	VanKooten	1" Iron in Mon. Box
1983	LCRC #3244	Byl	Set Kent County Monument
1991	LCRC #6041	Byl	Kent County Monument

P.A. 345 1990 KENT COUNTY
PEER APPROVED 2/25/99
CHAIRMAN Harry J. Huber

The position of this corner was previously approved by the Kent County Remonumentation Peer Group, monumented by William R. Byl on 2-28-83 and was recorded per LCRC #3244.

B. Description of corner evidence found and/or method applied in restoring or reestablishing corner:

M-5 Found Kent County Monument (Harrison) per witnesses from above LCRC as set by William R. Byl in place of the 1" Iron Pipe next to a 3/4" Iron in a Mon. Box he found. All check with Kent Co. Wits. and LCRC #717.

LCRC #3244	LCRC #6041
Nail & Remon. tag 24" Oak N40°E 45.72'	Nail & Remon. tag 30" Oak N40°E 45.76'
Nail & Remon. tag 18" Oak S30°E 41.83'	Nail & Remon. tag 24" Oak S30°E 41.83'
Nail & Remon. tag C.P. Pole N60°W 145.89'	Nail & Remon. tag C.P. Pole N60°W 145.78'
Nail & Remon. tag 12" Pine S50°W 42.90'	Nail & Remon. tag 12" Pine S50°E 42.84'
C/L B.T. is 3' North	


The selected location is accepted by me and is generally accepted by professional surveyors as the best available evidence of the position of the original corner.

C. Description of monument for corner and accessories established to perpetuate locating the position of the corner:

M-5 Standard Kent County Monument

Nail & KC Remon. tag W. side 30" Oak	N40°E	45.76'
Nail & KC Remon. tag N. side 24" Oak	S30°E	41.63'
Nail & KC Remon. tag N. side C.P. Pole	N60°W	145.78'
Nail & KC Remon. tag N. side 14" Pine,	S50°W	42.84'

C/L E-W blacktop road is North 3' ±

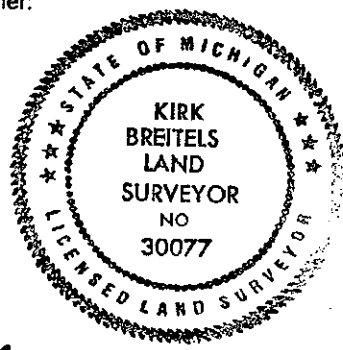

Signed by [Signature]
Surveyor's Michigan License No. 30077

Date 2/25/99