LAND CORNER RECORDATION CERTIFICATE
Filing Requirement of Act 74, Mich. P.A. 1970

For corners in

Keweenaw County

	Located in:			Corner Code #
1. Public Land Survey		T56N	R30W	E-5 ✓
		T56N	R30W	F-5
		T	R	
		T	R	
2. Property Controlling	S	T	R	
in Section	S	T	R	
3. Miscellaneous	S	T	R	
Property in Sec.	S	T	R	

4. Lot No. , Recorded Plat
5. Private Claims

REGISTER'S OFFICE } SS
County of Keweenaw
Received for Record, the 25th
day of October A.D. 2000
at 11:00 o'clock A. M., and Recorded
in Liber 2 of LCR
on page 4

Marilyn Wenquist
Register of Deeds

Register of Deeds Stamp & File Number

SURVEY & REMONUMENTATION

FEB 07 2001

SECTION

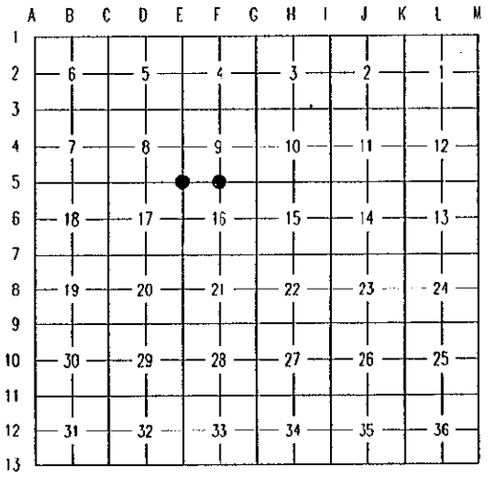

I, Steven C. Hein, in a field survey on May 26, 2000, do hereby state that under requirements of P.A. 74, Michigan P.A. of 1970, the corner points mentioned in lines 1 and 2 above were in conformance with regulations and rules therefore as required in the current manual of survey instructions of the United States Department of the Interior, Bureau of Land Management or by a decree of a Court of Law and /or that the corner points mentioned in lines 3, 4 and 5 above were in conformance with the rules of the Michigan Board of Land Surveyors or by a Decree of a Court of Law; established, re-established, monumented, recovered, found as expressed below:

NOTE: Not more than 2 corners, all in the same town and range, may be recorded on this certificate.

A. Description of original monument and accessories and/or subsequent restoration:

E-5: SW. Corner Section 9: From original notes: South true line between Sections 8 & 9; 80.00 Set post corner of Sections 8, 9, 16 & 17; Spruce 8 S87E 32; do 16 N70W 21. No evidence of original corner or accessories found.

F-5: S1/4 Corner Section 9: From original notes: East true line between Sections 9 & 16: 40.00 Mark quarter Section corner on Tamarack 8 inches (the tree as noted is the ¼ Sec. Corner); Tamarack 6 S50E 13; do 6 N20W 12. No evidence of original corner or accessories found.

B. Description of corner evidence found and/or method applied in restoring or reestablishing corner:

E-5: SW. Corner Section 9: Found 2 ½" Brass Cap on ¾" pipe, Cap stamped for corner by C. E. Hein, P.S. 13034. Corner found in heavy clearcut, 6' tall Spruce stumps left surrounding corner.

F-5: S1/4 Corner Section 9: Found 2 ½" Brass Cap on ¾" pipe, Cap stamped for corner by C. E. Hein, P.S. 13034. Found witness: 4" Maple N14°E 5.37'

C. Description of monument for corner and accessories established to perpetuate locating the position of the corner:

E-5: SW. Corner Section 9:
Replaced found monument with 4" Brass Cap stamped for corner on 1" pipe
Witnesses:
6" Spruce stump N02°E 5.66'
6" Spruce stump N43°E 6.81'
6" Spruce stump S88°E 9.01'
6" Spruce stump S07°E 8.44'
6" Spruce stump S58°W 7.01'

F-5: S1/4 Corner Section 9:
Replaced found monument with 4" Brass Cap stamped for corner on 1" pipe
Witnesses:
5"/2" twin H. Maple N59°E 6.72'
5" W. Birch S39°E 57.78'
8" H. Maple S60°W 4.79'
5" H. Maple N37°W 37.53'

Bearings are compass bearings, corrected for declination, all distances are to a nail and tag in the side of the witness object unless otherwise noted.

STATE OF MICHIGAN
STEVEN C. HEIN
PROFESSIONAL SURVEYOR
No. 32336
LICENSED PROFESSIONAL SURVEYOR

Ratified by Peer Group
In accordance with P.A. 345
Co. Rep. James M. Hollick
Date 10/24/00

Signed by Steven C. Hein

Date OCTOBER 21, 2000

Surveyor's Michigan License No. 32336

FORM APPROVED BY MICHIGAN STATE BOARD OF PROFESSIONAL SURVEYORS, JAN. 28, 1971
REVISED MAY 14, 1975
REVISED JAN., 1983
REVISED OCT., 1995

E556N30W.dot