

LAND CORNER RECORDATION CERTIFICATE
Filing Requirement of Act 74, Mich. P.A. 1970

For corners in

Keweenaw County Located in: Corner Code #

1. Public Land Survey T56N R30W G-3 ✓
 T56N R30W G-4
 T R
 T R
 T R
 T R

2. Property Controlling S T R
 in Section S T R
 3. Miscellaneous S T R
 Property in Sec. S T R

4. Lot No. , Recorded Plat
 5. Private Claims

**SURVEY &
 REMONUMENTATION**

FEB 07 2001

SECTION

REGISTER'S OFFICE
 County of Keweenaw } SS
 Received for Record, the 25th
 day of October A.D. 2000
 at 11:00 o'clock A. M., and Recorded
 in Liber 2 of LCR
 on page 2
Marilyn Weingart
 Register of Deeds
 Register of Deeds Stamp & File Number

I, Steven C. Hein, in a field survey on May 26, 2000, do hereby state that under requirements of P.A. 74, Michigan P.A. of 1970, the corner points mentioned in lines 1 and 2 above were in conformance with regulations and rules therefore as required in the current manual of survey instructions of the United States Department of the Interior, Bureau of Land Management or by a decree of a Court of Law and /or that the corner points mentioned in lines 3, 4 and 5 above were in conformance with the rules of the Michigan Board of Land Surveyors or by a Decree of a Court of Law; established, re-established, monumented, recovered, found as expressed below:

NOTE: Not more than 2 corners, all in the same town and range, may be recorded on this certificate.

A. Description of original monument and accessories and/or subsequent restoration:

G-3: NE Corner Section 9: From original notes: South true line between Secs. 3 & 4; 80.00 Set post of Sections 3, 4, 9 & 10; Y. Birch 13 S20E 33; do 10 N20W 15. No evidence of original corner or accessories found.

G-4: E1/4 corner Section 9; From original notes: South true line between Sections 9 & 10; 40.00 Set post quarter Section corner; Fir 8 S80E 34; tamarack 10 N10W 21. No evidence of original corner or accessories.

B. Description of corner evidence found and/or method applied in restoring or reestablishing corner:

G-3: NE Corner Section 9: Found 1 1/2" pipe, Calumet & Hecla location poster on 24" Y. Birch, 46' South of centerline logging road. No evidence of witnesses.


G-4: E1/4 corner Section 9: Found old 4" sq. post with Calumet & Hecla location poster dated 1954. Position fits well with corner to North. Accepted as best evidence of corner location.

C. Description of monument for corner and accessories established to perpetuate locating the position of the corner:

G-3: NE corner Section 9:
 Replaced 1 1/2" pipe with 4" Brass Cap
 Stamped for corner on 1" pipe
 Witnesses:
 8" Balsam N33°E 5.95'
 10" Cedar S01°W 54.29'
 4" R. Maple S23°W 12.95'
 24" Y. Birch N80°W 12.00'

G-4: E1/4 corner Section 9:
 Set 4" Brass Cap stamped for corner on
 1" pipe
 Witnesses:
 10" Spruce N64°E 30.00
 6" Spruce S40°E 11.26'
 5" Spruce S40°W 31.03'
 9" Spruce N81°W 41.58'

Bearings are compass bearings, corrected for declination, all distances are to a nail and tag in the side of the witness object unless otherwise noted.

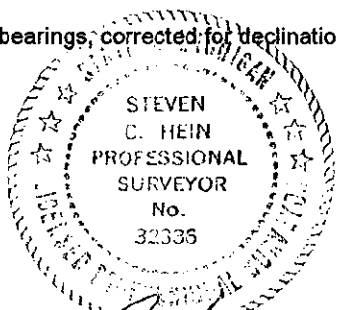

Ratified by Peer Group
In accordance with P.A. 345
 Co. Rep. James W. [Signature]
 Date 10/24/00

Signed by Steven C. Hein
 Surveyor's Michigan License No. 32336

Date October 21, 2000