

MAR 29 1999

LAND CORNER RECORDATION CERTIFICATE
Filing Requirement of Act 74, Mich. P.A. 1970

For corners in SECTION

Keweenaw County Located in: Corner Code #

1. Public Land Survey T57N R31W M2
T57N R31W M3
T R
T R

2. Property Controlling S T R
in Section S T R
3. Miscellaneous S T R
Property in Sec. S T R

4. Lot No. , Recorded Plat
5. Private Claims

REGISTER'S OFFICE } SS
County of Keweenaw }
Received for Record, the 12th
day of March A. D. 1999
at 12:00 o'clock P. M., and Recorded
in Liber 1 of LCR
on page 203
Marilyn Stinger
Register of Deeds
Register of Deeds Stamp & File Number

	A	B	C	D	E	F	G	H	I	J	K	L	M
1													
2	6		5		4		3		2		1		
3													
4	7		8		9		10		11		12		
5													
6	18		17		16		15		14		13		
7													
8	19		20		21		22		23		24		
9													
10	30		29		28		27		26		25		
11													
12	31		32		33		34		35		36		
13													

I, Steven C. Hein, in a field survey on October 20, 1998, do hereby state that under requirements of P.A. 74, Michigan P.A. of 1970, the corner points mentioned in lines 1 and 2 above were in conformance with regulations and rules therefore as required in the current manual of survey instructions of the United States Department of the Interior, Bureau of Land Management or by a decree of a Court of Law and for that the corner points mentioned in lines 3, 4 and 5 above were in conformance with the rules of the Michigan Board of Land Surveyors or by a Decree of a Court of Law; established, re-established, monumented, recovered, found as expressed below:

NOTE: Not more than 2 corners, all in the same town and range, may be recorded on this certificate.

A. Description of original monument and accessories and/or subsequent restoration:

M2: E1/4 Corner Section 1: From original notes: North on East side of Sec. 1 T57N, R31W; 40.00 Set qr. Sec. Post; Sugar 18 N9E 16 lks.; do 8 N52 1/2 W 24 lks. No evidence of original corner or accessories found.

M3: SE Corner Section 1: From original notes: North on East side of Sec. 12 T57N, R31W; 80.00 Set post corner to Secs. 1 & 12; B. Ash 14 N37E 18 lks.; Cedar 12 N84W 15 lks. No evidence of original corner or accessories found.

Ratified by Peer Group
In accordance with P.A. 345
Co. Rep. *James M. Hall*
Date 12/3/98

B. Description of corner evidence found and/or method applied in restoring or reestablishing corner:


M2: E1/4 Cor. Section 1: Found al. Location poster on 16" oak. Position fits well with split of East line Section 1. Set 1/4 Corner midway between found NE and SE Corners of Section 1

M3: SE Corner Section 1: Found 1 1/4" pipe as recorded in Liber 1 of L.C.R.C., Page 104. Witnesses of said record: 7" R. Maple N62°E 10.36'; 10" R. Maple S63°E 3.62'; 6" R. Maple S68°W 17.47'; 7" R. Maple N30°W 24.35'

C. Description of monument for corner and accessories established to perpetuate locating the position of the corner:

M2: Set 4" Brass Cap stamped for corner on 1" pipe
Witnesses:
15" Oak N63°E 6.54'
7" H. Maple S31°E 28.42'
6" H. Maple S79°W 26.90'
10" H. Maple N08°W 14.80'

M3: Replace 1 1/4" pipe with 4" Brass Cap stamped for corner on 1" pipe
Witnesses (checked):
8" R. Maple N63°E 10.34'
10" R. Maple S60°E 3.54'
7" R. Maple S69°W 17.55'
8" R. Maple N28°W 24.41'

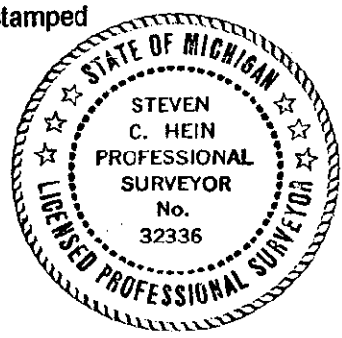

Bearings are compass bearings, corrected for declination, all distances are to a nail and tag in the side of the witness object unless otherwise noted.

Signed by *Steven C. Hein*
Surveyor's Michigan License No. 32336

Date 3/10/99