SURVEY & REMONUMENTATION

NOV 23 1999

SECTION

LAND CORNER RECORDATION CERTIFICATE

Filing Requirement of Act 74, Mich. P.A. 1970

For corners in Keweenaw (County)

	Located In:	Corner Code ##
1. Public Land Survey	T 57N R 30W	C5 ✓
	T 57N R 30W	MC C5-D5 (4)
	T R	
	T R	
2. Property Controlling	S T R	
in Section	S T R	
3. Miscellaneous	S T R	
Property in Sec.	S T R	

REGISTER'S OFFICE
County of Keweenaw } SS
Received for Record, the 12th day of November A.D. 1996 at 9:00 o'clock A.M., and Recorded in Liber 1 of LCR on page 149
Marilyn Weinquist
Register of Deeds

Register of Deeds Stamp & File Number

4. Lot No. _____ , Recorded Plat _____
5. Private Claims _____

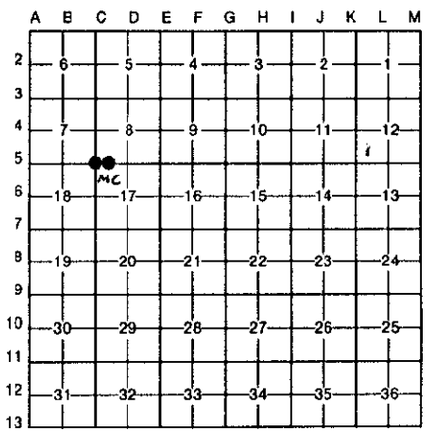

I, Steven C. Hein, in a field survey on June 28, 1996, 19 _____, do hereby certify that under requirements of P.A. 74, Michigan P.A. of 1970, the corner points mentioned in lines 1 and 2 above were in conformance with regulations and rules therefore as required in the current manual of survey instructions of the United States Department of the Interior, Bureau of Land Management or by a decree of a Court of Law and/or that the corner points mentioned in lines 3, 4 and 5 above were in conformance with the rules of the Michigan Board of Land Surveyors or by a Decree of a Court of Law; established, re-established, monumented, re-monumented, recovered, found as expressed below:

NOTE: Not more than 4 corners, all in the same town and range, may be recorded on this certificate.

A. Description of original monument and accessories and/or subsequent restoration:
(C-5) From Original Notes: 80.00 Set post corner of Sections 7, 8, 17 & 18; Cedar 6 N54W 18; do 10 S15E 12: No evidence of original corner or accessories.
(C-5/D-5)M.C. From Original Notes: 15.90 Intersected Lake Set Meander post; Cedar 9 S78W 39; Spruce 7 N81 1/2W 38: No evidence of original corner or accessories.

B. Description of corner evidence found and/or method applied in restoring or reestablishing corner:
(C-5) Found 1" pipe as recorded on L.C.R. liber 1, Page 95: Witnesses: 9" Balsam N50E 9.96'; 10" Cedar S74E 16.45'; 6" Cedar S05E 16.73'; 8" Cedar S73W 20.66'
(C-5/D-5)M.C. Found 3/4" pipe, 31' West of Gratiot Lake and 8.3' Northeasterly of cabin wall, as recorded in L.C.R. Liber 1, Page 95: Witnesses: 12" S. Maple S61E 15.02'; 6" Balsam S11W 28.12'; SW Cor. Cabin S13W 10.40'

Ratified by Peer Group
In accordance with P.A. 345
Co. Rep. James M. Kelbli
Date 10/15/96

C. Description of monument for corner and accessories established to perpetuate locating the position of the corner:

(C-5) Accepted location of 1" pipe, Replaced with 4" Remon. Brass Cap stamped for corner
Accepted old Witnesses:
9" Balsam N50E 9.96'
10" Cedar S74E 16.45'
6" Cedar S05E 16.73'
8" Cedar S73W 20.66'
Note: Wit. have nail in side blaze.

(C-5/D-5)M.C. Accepted location of 3/4" pipe, Replaced with 4" Remon. Brass Cap stamped for corner
Witnesses:
13" R. Maple S60E 15.27'
8" Balsam S12W 28.15'
15" W. Birch N53W 30.90'
10" Balsam N21W 44.76'
Note: Wit. have tag #32336

STATE OF MICHIGAN
STEVEN C. HEIN
PROFESSIONAL SURVEYOR
No. 32336
LICENSED PROFESSIONAL SURVEYOR

Signed by Steven C. Hein Date September 13, 1996

Surveyor's Michigan License No. 32336

FORM APPROVED BY MICHIGAN STATE BOARD OF LAND SURVEYORS, JAN. 28, 1971
REVISED MAY 14, 1975
REVISED JAN., 1983