

**SURVEY & REMONUMENTATION**

NOV 23 1999

SECTION

**LAND CORNER RECORDATION CERTIFICATE**  
Filing Requirement of Act 74, Mich. P.A. 1970

For corners in  
Keweenaw

(County)

Located In:

Corner Code #

- |                                       |                         |                      |
|---------------------------------------|-------------------------|----------------------|
| 1. Public Land Survey                 | T 57N R 30W             | D3 ✓<br>MC D3-E3 (3) |
|                                       | T 57N R 30W             |                      |
|                                       | T _____ R _____         |                      |
|                                       | T _____ R _____         |                      |
| 2. Property Controlling in Section    | S _____ T _____ R _____ |                      |
|                                       | S _____ T _____ R _____ |                      |
| 3. Miscellaneous Property in Sec.     | S _____ T _____ R _____ |                      |
|                                       | S _____ T _____ R _____ |                      |
| 4. Lot No. _____, Recorded Plat _____ |                         |                      |
| 5. Private Claims _____               |                         |                      |

REGISTER'S OFFICE }  
County of Keweenaw } SS 12  
Received for Record, the 12  
day of November A.D. 1996  
at 9:00 o'clock A.M., and Recorded  
in Liber 1 of LCR  
on page 148  
Maureen W. Winkler  
Register of Deeds

Register of Deeds Stamp & File Number

A	B	C	D	E	F	G	H	I	J	K	L	M
2	6	5	4	3	2	1						
3		•	•									
4	7	8	9	10	11	12						
5												
6	18	17	16	15	14	13						
7												
8	19	20	21	22	23	24						
9												
10	30	29	28	27	26	25						
11												
12	31	32	33	34	35	36						
13												

I, Steven C. Hein, in a field survey on June 28, 1996, 19\_\_\_\_\_, do hereby certify that under requirements of P.A. 74, Michigan P.A. of 1970, the corner points mentioned in lines 1 and 2 above were in conformance with regulations and rules therefore as required in the current manual of survey instructions of the United States Department of the Interior, Bureau of Land Management or by a decree of a Court of Law and/or that the corner points mentioned in lines 3, 4 and 5 above were in conformance with the rules of the Michigan Board of Land Surveyors or by a Decree of a Court of Law; established, re-established, monumented, re-monumented, recovered, found as expressed below:

**NOTE: Not more than 4 corners, all in the same town and range, may be recorded on this certificate.**


A. Description of original monument and accessories and/or subsequent restoration:  
(D-3) From Original Notes: 40.00 Set qr. Section post; Sugar 12 S82W 32; do 12 N41E 28: No evidence of original corner or accessories.  
(D-3/E-3)M.C. From Original Notes: 53.15 Intersected Lake Set Meander post; Yellow Birch 10 N81W 14; Fir 6 S82W 16: No evidence of original corner or accessories.

B. Description of corner evidence found and/or method applied in restoring or reestablishing corner:  
(D-3) Found Bit end of 1" hex drill rod. Witnesses of record: 8" Pine N80E 8.44'; 14" Maple S50W 11.58'; 4" Pine S45E 6.33'  
(D-3/E-3)M.C. Found 1 1/4" pipe over 1" pin, 25' West of Gratiot Lake. No apparent witnesses.

C. Description of monument for corner and accessories established to perpetuate locating the position of the corner:

(D-3) Accepted location of drill rod Replaced with 4" Remon. Brass Cap stamped for corner Witnesses (New): 10" H. Maple N25E 16.80' 3" H. Maple S40E 16.52' 14" H. Maple S48W 11.61' 16" H. Maple N49W 33.66' Note: Wit. have tag #32336	(D-3/E-3)M.C. Accepted location of 1" pin, Replaced with 4" Remon. Brass Cap stamped for corner Witnesses: 16" Elm N17E 32.24' 14" Ash S35W 60.23' 4" Oak S73W 36.69' 9" Balsam N30W 37.08' Note: Wit. have tag #32336
--	--

Ratified by Peer Group  
In accordance with P.A. 345  
Co. Rep. James M. Habbe  
Date 10/15/96

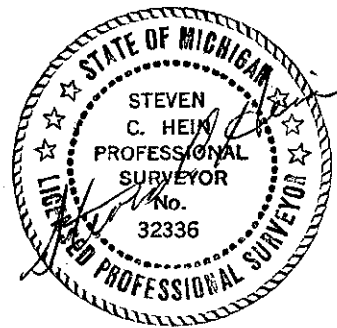

Signed by Steven C. Hein Date SEPTEMBER 13, 1996  
Surveyor's Michigan License No. 32336