SURVEYOR REMONUMENTATION SECTION

DEC 16 1998

LAND CORNER RECORDATION CERTIFICATE
Filing Requirement of Act 74, Mich. P.A. 1970

REGISTER'S OFFICE } SS
County of Keweenaw
Received for Record, the 4th day of December A. D. 1998 at 11:00 o'clock A. M., and Recorded in Liber 1 of LCR on page 193
Marilyn Wangnit
Register of Deeds
Register of Deeds Stamp & File Number

For corners in

Keweenaw County

	Located in:			Corner Code #
1. Public Land Survey		T57N	R30W	G1
		T57N	R30W	H1 ✓
		T	R	
		T	R	
2. Property Controlling	S	T	R	
in Section	S	T	R	
3. Miscellaneous	S	T	R	
Property in Sec.	S	T	R	

4. Lot No. , Recorded Plat
5. Private Claims

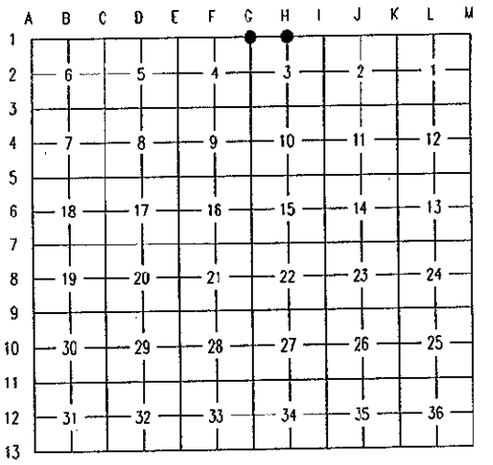

I, Steven C. Hein, in a field survey on October 20, 1998, do hereby state that under requirements of P.A. 74, Michigan P.A. of 1970, the corner points mentioned in lines 1 and 2 above were in conformance with regulations and rules therefore as required in the current manual of survey instructions of the United States Department of the Interior, Bureau of Land Management or by a decree of a Court of Law and /or that the corner points mentioned in lines 3, 4 and 5 above were in conformance with the rules of the Michigan Board of Land Surveyors or by a Decree of a Court of Law; established, re-established, monumented, recovered, found as expressed below:

NOTE: Not more than 2 corners, all in the same town and range, may be recorded on this certificate.

A. Description of original monument and accessories and/or subsequent restoration:

G1: Corner between Sections 3 & 4: From original notes: North between Sections 3 & 4: 80.58 Intersected South boundary of Township 58 North 2.65 East of Corner of Sections 33 & 34. Set post corner of Secs. 3 & 4; White Pine 8 S54W 7; do 6 S44E 10. No evidence of original corner or accessories found.

H1: N1/4 Corner Section 3: Not set in original survey.

Ratified by Peer Group
In accordance with P.A. 345
Co. Rep. [signature]
Date 12/3/98

B. Description of corner evidence found and/or method applied in restoring or reestablishing corner:

G1: Corner between Sections 3 & 4: Having found the recorded Northwest and Northeast Corners of the Township, all the GLO corners between were set on a true parallel of latitude established by using the secant Method. Position fits well with found evidence.

H1: N1/4 Corner Section 3: Having found the recorded Northwest and Northeast Corners of the Township, all the GLO corners between were set on a true parallel of latitude established by using the secant method. Quarter corners were established satisfying the proportional area measurements as shown on the original Township Plat. Positions fit well with found evidence.

C. Description of monument for corner and accessories established to perpetuate locating the position of the corner:

G1: Set 4" Brass Cap stamped for corner on 1" pipe, 5" A.G., 12' No. of Power line
Witnesses:
6" Oak N47°E 35.42'
5" Oak S26°E 44.99'
Util. Pole S73°W 30.54'
12" Oak N37°W 42.73'
(12" Birch w/ tag bears N43°W 21.8')

H1: Set 4" Brass Cap stamped for corner on 1" pipe, 10" A.G., 11' No. of Power line
Witnesses:
8" H. Maple N22°E 56.26'
Util. Pole S77°E 59.07'
8" H. Maple S37°W 65.84'
Fd. Hex drill rod N69°51'09"W 24.85'

STATE OF MICHIGAN
STEVEN C. HEIN
PROFESSIONAL SURVEYOR
No. 32336
LICENSED PROFESSIONAL SURVEYOR

Bearings are compass bearings, corrected for declination, all distances are to a nail and tag in the side of the witness object unless otherwise noted.

Signed by [signature] Date 11/14/98

Surveyor's Michigan License No. 32336

FORM APPROVED BY MICHIGAN STATE BOARD OF PROFESSIONAL SURVEYORS, JAN. 28, 1971
REVISED MAY 14, 1975
REVISED JAN., 1983
REVISED OCT., 1995

E157N30W.dot