## LAND CORNER RECORDATION CERTIFICATE Filing Requirement of Act 74, Mich. P.A. 1970

For corners in				
Keweenaw County	Located	in:		Corner Code #
1. Public Land Surve	y	T57N T57N T T	R30W R30W R R	11 V
2. Property Controlling in Section	ng S S	T T	R R	
Miscellaneous Property in Sec.	S S	T T	R R	
4. Lot No.	Recorded Plat			

5. Private Claims

REGISTER'S OFFICE SECTION County of Keweenaw Received for Record, the day of December A. D. 1998 at 1:00 o'clock 4. M., and Recorded in Liber on page Register of Deeds Is Stamp & File Number

> F G Н

C Đ


20


29

2 3

12 13

4 5 I, Steven C. Hein, in a field survey on October 20, 1998, do hereby state that under requirements of P.A. 74, Michigan P.A. of 1970, the corner points mentioned in lines 1 and 2 above were in 6 conformance with regulations and rules therefore as required in the current manual of survey instructions of the United States Department of the Interior, Bureau of Land Management or by a 7 decree of a Court of Law and /or that the corner points mentioned in lines 3, 4 and 5 above were Я In conformance with the rules of the Michigan Board of Land Surveyors or by a Decree of a Court 9 of Law; established, re-established, monumented, recovered, found as expressed below: 10 11

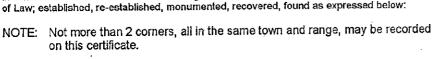

 

11: Corner between Sections 2 & 3: From original notes: North between Sections 2 & 3: 80.45 Intersected South boundary of Township 58 North 2.38 East of Corner of Sections 34 & 35. Set post corner of Sections 2 & 3; Red Oak 16 S23E 35; Fir 8 S55W 38. Noevidence of original corner or accessories found.

J1: N1/4 Corner Section 2: Not set in original survey.

Ratified by Peer Group

B. Description of corner evidence found and/or method applied in restoring or reestablishing corner

11: Corner between Sections 2 & 3: Having found the recorded Northwest and Northeast Corners of the Township, all the GLO corners between were set on a true parallel of latitude established by using the secant Method. Position fits well with found evidence.

J1: N1/4 Corner Section 2: Having found the recorded Northwest and Northeast Corners of the Township, all the GLO corners between were set on a true parallel of latitude established by using the secant method. Quarter corners were established satisfying the proportional area measurements as shown on the original Township Plat. Positions fit well with found evidence.

C. Description of monument for corner and accessories established to perpetuate locating the position of the corner:

I1: Set 4" Brass Cap stamped for corner on 1" pipe, 4" A.G., 7' No. of Power line Witnesses: 16" Oak N49°E 49.11' 12" H. Maple S11°E 45.23' 16" H. Maple S55°W 66.25' 16" H. Maple N28°W 32.13'

J1: Set 4" Brass Cap stamped for corner on 1" pipe, 3" A.G., 9' No. of Power line Witnesses: 6" Y. Birch N36°E 37.65' 9" Ironwood S37°E 55.80' Util. Pole S79°W 32.61' 9" Balsam N50°W 43.66' (12" Maple snag w/ tag bears N82°W 29.6")



Bearings are compass bearings, corrected for declination, all distances are to a nail and tag in the side of the witness object unless otherwise noted.

11/14/98

Surveyor's Michigan License No. 32336

FORM APPROVED BY MICHIGAN STATE BOARD OF PROFESSIONAL SURVEYORS, JAN. 28, 1971 REVISED MAY 14, 1975 REVISED JAN., 1983 REVISED OCT., 1995