

**SURVEY &  
REMONUMENTATION**

APR 28 1995

**COMMISSION**

**LAND CORNER RECORDATION CERTIFICATE  
Filing Requirement of Act 74, Mich. P.A. 1970**

For corners in

Keweenaw  
(County)

Located In:

Corner Code #

- |                                    |   |            |   |            |              |
|------------------------------------|---|------------|---|------------|--------------|
| 1. Public Land Survey              | T | <u>57N</u> | R | <u>32W</u> | <u>C-5</u> ✓ |
|                                    | T | <u>57N</u> | R | <u>32W</u> | C-4          |
|                                    | T |            | R |            |              |
|                                    | T |            | R |            |              |
| 2. Property Controlling in Section | S |            | T |            | R            |
|                                    | S |            | T |            | R            |
| 3. Miscellaneous Property in Sec.  | S |            | T |            | R            |
|                                    | S |            | T |            | R            |
- per Co. Rep.*

REGISTER'S OFFICE }  
County of Keweenaw } SS  
Received for Record, the 15<sup>th</sup>  
day of December A.D. 1994  
at 2:00 o'clock P.M., and Recorded  
in Liber LCR of LCR  
on page 127  
*Manly Utting*  
Register of Deeds

**Register of Deeds Stamp & File Number**

4. Lot No. \_\_\_\_\_, Recorded Plat \_\_\_\_\_
5. Private Claims \_\_\_\_\_

|    | A  | B | C  | D | E  | F | G  | H | I  | J | K  | L | M |
|----|----|---|----|---|----|---|----|---|----|---|----|---|---|
| 2  | 6  |   | 5  |   | 4  |   | 3  |   | 2  |   | 1  |   |   |
| 3  |    |   |    |   |    |   |    |   |    |   |    |   |   |
| 4  | 7  | ● | 8  |   | 9  |   | 10 |   | 11 |   | 12 |   |   |
| 5  |    | ● |    |   |    |   |    |   |    |   |    |   |   |
| 6  | 18 |   | 17 |   | 16 |   | 15 |   | 14 |   | 13 |   |   |
| 7  |    |   |    |   |    |   |    |   |    |   |    |   |   |
| 8  | 19 |   | 20 |   | 21 |   | 22 |   | 23 |   | 24 |   |   |
| 9  |    |   |    |   |    |   |    |   |    |   |    |   |   |
| 10 | 30 |   | 29 |   | 28 |   | 27 |   | 26 |   | 25 |   |   |
| 11 |    |   |    |   |    |   |    |   |    |   |    |   |   |
| 12 | 31 |   | 32 |   | 33 |   | 34 |   | 35 |   | 36 |   |   |
| 13 |    |   |    |   |    |   |    |   |    |   |    |   |   |

I, John I. Haataja, in a field survey on November 21, 1994, do hereby certify that under requirements of P.A. 74, Michigan P.A. of 1970, the corner points mentioned in lines 1 and 2 above were in conformance with regulations and rules therefore as required in the current manual of survey instructions of the United States Department of the Interior, Bureau of Land Management or by a decree of a Court of Law and/or that the corner points mentioned in lines 3, 4 and 5 above were in conformance with the rules of the Michigan Board of Land Surveyors or by a Decree of a Court of Law; established, re-established, monumented, re-monumented, recovered, found as expressed below:

**NOTE: Not more than 4 corners, all in the same town and range, may be recorded on this certificate.**

**A. Description of original monument and accessories and/or subsequent restoration:**


**C-5** Section Cor. 7,8,17 & 18, T55N-R32W  
Orig. Notes: Wood post set for corner.  
W. Pine 30" N 70° W 50 lks.  
W. Pine 30" S 60° E 28 lks.  
1½" iron pipe set in place of wood stakes on 9/15/21 by F. W. Halsey and Joseph Allwin.  
2" pipe per LCR1, Page 30 on 6/13/83.

**C-4** 1/4 Corner between Sec. 7 & 8  
Orig. Notes: Wood post for corner.  
Cedar 12" S 50° W 9 lks.  
Cedar 10" S 70° E 2 lks.

**B. Description of corner evidence found and/or method applied in restoring or reestablishing corner:**

**C-5** Section Cor. 7,8,17 & 18, T57N-R32W  
Found 1½" pipe pulled out. Restored corner from reference ties.

**C-4** 1/4 Corner between Sec. 7 & 8  
Found 1½" iron pipe as noted in Calumet & Hecla Mining Co. records and at location consistent with measurements to other corners. Restored corner at location of 1½" pipe.

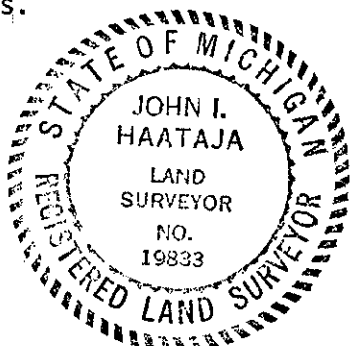

Ratified by Peer Group  
In accordance with P.A. 345  
Co. Rep. *James M. Hulse*  
Date 11/16/94

**C. Description of monument for corner and accessories established to perpetuate locating the position of the corner:**

**C-5** Section Cor. 7,8,17 & 18, T57N-R32W  
Set 1" pipe with brass cap as a careful and faithful perpetuation of the position of the original corner.  
Utility Pole N 71° E 24.37'  
18" Maple S 32° W 97.59'  
6" B. Fir N 52° W 34.50'  
10" H. Maple N 11° E 50.28'

**C-4** 1/4 Corner between Sec. 7 & 8  
Cemented brass cap to 1½" iron pipe as a careful and faithful perpetuation of the position of the original corner.  
10" Y. Birch S 2° E 6.81'  
12" Y. Birch N 10° E 7.13'  
10" R. Maple N 77° W 27.72'  
8" Cedar S 77° E 33.46'

Signed by *John I. Haataja*  
Surveyor's Michigan License No. 19833

Date November 23, 1994