

**SURVEY &
REMONUMENTATION**

APR 28 1995

COMMISSION

LAND CORNER RECORDATION CERTIFICATE
Filing Requirement of Act 74, Mich. P.A. 1970

For corners in

Keweenaw
(County)

Located In:

Corner Code ##

- | | | | | | |
|---------------------------------------|---|------------|---|------------|------------|
| 1. Public Land Survey | T | <u>57N</u> | R | <u>32W</u> | <u>D-1</u> |
| | T | | R | | |
| | T | | R | | |
| | T | | R | | |
| 2. Property Controlling in Section | S | | T | R | |
| | S | | T | R | |
| 3. Miscellaneous Property in Sec. | S | | T | R | |
| | S | | T | R | |
| 4. Lot No. _____, Recorded Plat _____ | | | | | |
| 5. Private Claims _____ | | | | | |

REGISTER'S OFFICE }
County of Keweenaw } SS
Received for Record, the 15th
day of December A.D. 19 94
at 3:00 o'clock P. M., and Recorded
in Liber 117 of LCR
on page 117
Maileg Wingmat
Register of Deeds

Register of Deeds Stamp & File Number

	A	B	C	D	E	F	G	H	I	J	K	L	M
2	6		5		4		3		2		1		
3													
4	7		8		9		10		11		12		
5													
6	18		17		16		15		14		13		
7													
8	19		20		21		22		23		24		
9													
10	30		29		28		27		26		25		
11													
12	31		32		33		34		35		36		
13													

I, John I. Haataja, in a field survey on November 18, 19 94
do hereby certify that under requirements of P.A. 74, Michigan P.A. of 1970, the corner points mentioned in lines 1 and 2 above were in conformance with regulations and rules therefore as required in the current manual of survey instructions of the United States Department of the Interior, Bureau of Land Management or by a decree of a Court of Law and/or that the corner points mentioned in lines 3, 4 and 5 above were in conformance with the rules of the Michigan Board of Land Surveyors or by a Decree of a Court of Law; established, re-established, monumented, re-monumented, recovered, found as expressed below:


NOTE: Not more than 4 corners, all in the same town and range, may be recorded on this certificate.

A. Description of original monument and accessories and/or subsequent restoration:
D-1 1/4 Corner between Section 32, T58N-R32W and 5, T57N-R32W
Orig. Notes: Wood Post
Spruce 8" N 68° E 41 lks.
Cedar 10" N 77° W 25 lks.

B. Description of corner evidence found and/or method applied in restoring or reestablishing corner:
D-1 1/4 Corner between Section 32, T58N-R32W and 5, T57N-R32W
No trace of original corner.
Re-established corner by single proportionate measure between Section corners.

C. Description of monument for corner and accessories established to perpetuate locating the position of the corner:
D-1 1/4 Corner between Section 32, T58N-R32W and 5, T57N-R32W
Set 1" pipe with brass cap as careful and faithful re-establishment of the position of the original corner.
5" Cedar S 63° W 40.17'
5" Spruce N 77° W 35.19'
10" Spruce N 21° W 37.78'
10" Spruce N 80° E 21.75'

Ratified by Peer Group
In accordance with P.A. 345
Co. Rep. *James M. Hall*
Date 11/16/94

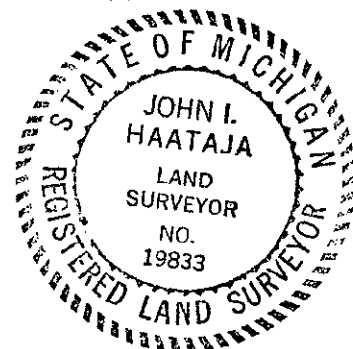

Signed by *John I. Haataja*
Surveyor's Michigan License No. 19833

Date November 22, 1994