

**SURVEY &  
REMONUMENTATION**

**OCT 08 1997**

**COMMISSION**

**LAND CORNER RECORDATION CERTIFICATE**

**Filing Requirement of Act 74, Mich. P.A. 1970**

For corners in  
KEWEENAW  
(County)

Located In:

Corner Code #

REGISTER'S OFFICE

County of Keweenaw } SS

Received for Record, the 29<sup>th</sup>

day of July A.D. 1997

at 10:00 o'clock A.M., and Recorded

in Liber 1 of LCR

on page 166

Marilyn Wenquist  
Register of Deeds

- |                                    |   |            |   |            |             |
|------------------------------------|---|------------|---|------------|-------------|
| 1. Public Land Survey              | T | <u>57N</u> | R | <u>32W</u> | <u>E-12</u> |
|                                    | T |            | R |            |             |
|                                    | T |            | R |            |             |
|                                    | T |            | R |            |             |
| 2. Property Controlling in Section | S |            | T |            |             |
|                                    | S |            | T |            |             |
| 3. Miscellaneous                   | S |            | T |            |             |
| Property in Section                | S |            | T |            |             |

Register of Deeds Stamp & File Number

4. Lot No. \_\_\_\_\_, Recorded Plat \_\_\_\_\_
5. Private Claims \_\_\_\_\_

7													
8	19	20	21	22	23	24							
9													
10	30	29	28	27	26	25							
11													
12	31	32	33	34	35	36							
13													


I, R. W. CRAMPTON, in a field survey on JUNE 5, 1985 do hereby certify that under requirements of P.A. 74, Michigan P.A. of 1970, the corner points mentioned in lines 1 and 2 above were in conformance with regulations and rules therefore as required in the current manual of survey instructions of the United States Department of the Interior, Bureau of Land Management or by a decree of a Court of Law and/or that the corner points mentioned in lines 3, 4 and 5 above were in conformance with the rules of the Michigan Board of Professional Surveyors or by a Decree of a Court of Law; established, re-established, monumented, re-monumented, recovered, found as expressed below:

**NOTE: Not more than 4 corners, all in the same town and range, may be recorded on this certificate.**

A. Description of original monument and accessories and/or subsequent restoration:  
E-12 EAST 1/4 CORNER-SET POST-TAMARACK 18 S18E 37, FIR 12 N40W 6.

Ratified by Peer Group  
In accordance with P.A. 345  
Co. Rep. James M. Lubelt  
Date 7/28/97

B. Description of corner evidence found and/or method applied in restoring or reestablishing corner:  
E-12 EAST 1/4 CORNER-2 1/2" IRON PIPE FOUND AND SET WITH 4" BRASS CAP.

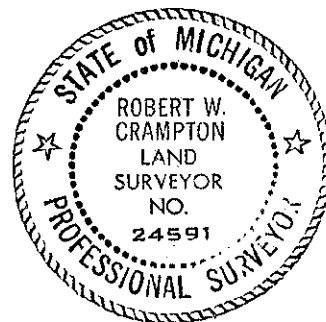

C. Description of monument for corner and accessories established to perpetuate locating the position of the corner:  
E-12 THE 2 1/2" IRON PIPE WITH 4" BRASS CAP WAS WITNESSED WITH SURVEY TAG NAILED TO:  
5" MAPLE TREE S61 E 5.15', 12" MAPLE TREE S5 E 20.25',  
16" CEDAR TREE N57 W 22.80', 14" TWIN MAPLE TREE N4 W 27.64'.

Signed by Robert W. Crampton  
Surveyor's Michigan License No. 24591

Date JULY 22, 1997