

SURVEY & REMONUMENTATION

OCT 08 1997

COMMISSION

LAND CORNER RECORDATION CERTIFICATE

Filing Requirement of Act 74, Mich. P.A. 1970

For corners in KEWEENAW
(County)

Located in:

Corner Code #

- | | | | | |
|--------------------------------------|---|------------|---|------------|
| 1. Public Land Survey | T | <u>52N</u> | R | <u>32W</u> |
| | T | <u>57N</u> | R | <u>32W</u> |
| | T | | R | |
| | T | | R | |
| 2. Property Controlling in Section | S | | T | R |
| | S | | T | R |
| 3. Miscellaneous Property in Section | S | | T | R |
| | S | | T | R |

F-13 ✓
E-11

REGISTER'S OFFICE }
County of Keweenaw } SS
Received for Record, the 29th
day of July A.D. 1997
at 10:00 o'clock A.M., and Recorded
in Liber 1 of LCR
on page 170
Manya Wenzel
Register of Deeds

Register of Deeds Stamp & File Number

4. Lot No. _____, Recorded Plat _____
5. Private Claims _____

A	B	C	D	E	F	G	H	I	J	K	L	M
2	6	5	4	3	2							
3												
4	7	8	9	10	11	12						
5												
6	18	17	16	15	14	13						
7												
8	19	20	21	22	23	24						
9												
10	30	29	28	27	26	25						
11												
12	31	32	33	34	35	36						
13												


I, R. W. CRAMPTON, in a field survey on JUNE 20, 1985, do hereby certify that under requirements of P.A. 74, Michigan P.A. of 1970, the corner points mentioned in lines 1 and 2 above were in conformance with regulations and rules therefore as required in the current manual of survey instructions of the United States Department of the Interior, Bureau of Land Management or by a decree of a Court of Law and/or that the corner points mentioned in lines 3, 4 and 5 above were in conformance with the rules of the Michigan Board of Professional Surveyors or by a Decree of a Court of Law; established, re-established, monumented, re-monumented, recovered, found as expressed below:

NOTE: Not more than 4 corners, all in the same town and range, may be recorded on this certificate.

- A. Description of original monument and accessories and/or subsequent restoration:
F-13 SOUTH 1/4 CORNER SECTION 33-SET POST-SUGAR 22 N13E 17, SUGAR 12 N78W 26.
E-11 SOUTHWEST CORNER SECTION 28-SET POST- SUGAR 12 S50E 43, SUGAR 14 N60W 16.

Ratified by Peer Group
In accordance with P.A. 345
Co. Rep. James M. Hahel
Date 7/28/97

- B. Description of corner evidence found and/or method applied in restoring or reestablishing corner:
F-13 SOUTH 1/4 CORNER SECTION 33-3/4" HEXAGON PIN IN CONCRETE FOUND.
E-11 SOUTHWEST CORNER SECTION 28-1/2" RE-ROD FOUND FROM HIGHWAY DEPARTMENT NOTES.

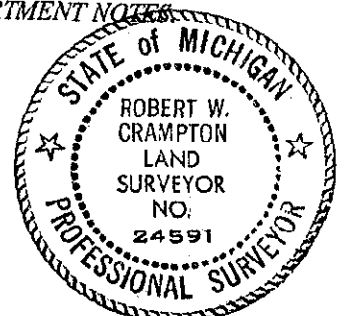

- C. Description of monument for corner and accessories established to perpetuate locating the position of the corner:
F-13 SOUTH 1/4 CORNER SECTION 33-3/4" HEXAGON PIN WAS WITNESSED WITH SURVEY TAG NAILED TO:
 4" MAPLE TREE N30 E 12.58', 8" ELM TREE S66 E 6.66',
 12" ASPEN TREE S53 W 13.91', 10" ELM TREE S11 W 18.72'.
E-11 SOUTHWEST CORNER SECTION 28-1/2" RE-ROD WAS WITNESSED WITH SURVEY TAG NAILED TO:
 8" MAPLE TREE N31 W 34.08', 4" CEDAR TREE N58 E 43.0',
 10" MAPLE TREE S27 E 102.50', 10" MAPLE TREE S19 W 98.55'.

Signed by Robert W. Crampton
Surveyor's Michigan License No. 24591

Date July 22, 1997