

REMONUMENTATION

MAR 19 1997

COMMISSION

LAND CORNER RECORDATION CERTIFICATE
Filing Requirement of Act 74, Mich. P.A. 1970

For corners in KEWEENAW - REMON Located in:
 (County)

Corner Code #

REGISTER'S OFFICE }
 County of Keweenaw } SS
 Received for Record, the 8th
 day of November A.D. 1996
 at 11:00 o'clock A.M., and Recorded
 in Liber 1 of L.C.R.
 on page 142
Roberta Rosambarger Deputy
 Register of Deeds

- | | | | | |
|--------------------------------------|---|------------|---|------------|
| 1. Public Land Survey | T | <u>57N</u> | R | <u>32W</u> |
| | T | | R | |
| | T | | R | |
| | T | | R | |
| 2. Property Controlling in Section | S | | T | R |
| | S | | T | R |
| 3. Miscellaneous Property in Section | S | | T | R |
| | S | | T | R |

G-11

Register of Deeds Stamp & File Number

4. Lot No. _____, Recorded Plat _____
 5. Private Claims _____

I, R. W. CRAMPTON, in a field survey on JUNE 01, 1994
 do hereby certify that under requirements of P.A. 74, Michigan P.A. of 1970, the corner points mentioned in lines 1 and 2 above were in conformance with regulations and rules therefore as required in the current manual of survey instructions of the United States Department of the Interior, Bureau of Land Management or by a decree of a Court of Law and/or that the corner points mentioned in lines 3, 4 and 5 above were in conformance with the rules of the Michigan Board of Professional Surveyors or by a Decree of a Court of Law; established, re-established, monumented, re-monumented, recovered, found as expressed below:

A	B	C	D	E	F	G	H	I	J	K	L	M
2	6	5	4	3	2	1						
3												
4	7	8	9	10	11	12						
5												
6	18	17	16	15	14	13						
7												
8	19	20	21	22	23	24						
9												
10	30	29	28	27	26	25						
11												
12	31	32	33	34	35	36						
13												


NOTE: Not more than 4 corners, all in the same town and range, may be recorded on this certificate.

A. Description of original monument and accessories and/or subsequent restoration:

G-11 SET POST SUGAR 14 S14W 11, SPRUCE 12 N6E 50

B. Description of corner evidence found and/or method applied in restoring or reestablishing corner:

G-11 1" IRON PIN IN 2' x 2' CONCRETE PAD, FENCE TO SOUTH, GRAVEL ROAD N & E OF CORNER

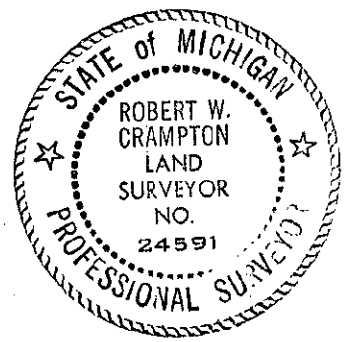

C. Description of monument for corner and accessories established to perpetuate locating the position of the corner:

G-11 THE 1" IRON PIN WITH 4" BRASS CAP WAS WITNESSED WITH SURVEY TAG NAILED TO: UTILITY POLE S20E 24.01', 16" MAPLE TREE S89W 24.58', 8" W. BIRCH TREE N60W 41.08', 16" W. BIRCH TREE N34W 66.61'.

Ratified by Peer Group
 In accordance with P.A. 345
 Co. Rep. [Signature]
 Date 10/15/96

Signed by Robert W. Crampton

Date OCTOBER 1, 1996

Surveyor's Michigan License No. 24591