

SURVEY & REMONUMENTATION

MAR 19 1997

COMMISSION

LAND CORNER RECORDATION CERTIFICATE

Filing Requirement of Act 74, Mich. P.A. 1970

For corners in KEWEENAW - REMON
(County)

Located in:

Corner Code #

- | | | | | | |
|--------------------------------------|---|------------|---|------------|-----------|
| 1. Public Land Survey | T | <u>57N</u> | R | <u>32W</u> | <u>19</u> |
| | T | | R | | |
| | T | | R | | |
| | T | | R | | |
| 2. Property Controlling in Section | S | | T | R | |
| | S | | T | R | |
| 3. Miscellaneous Property in Section | S | | T | R | |
| | S | | T | R | |

REGISTER'S OFFICE

County of Keweenaw } SS

Received for Record, the 8th

day of November A.D. 1996

at 11:00 o'clock A.M., and Recorded

in Liber 1 of LCE

on page 138

Roberta Rosenberger Deputy

Register of Deeds

Register of Deeds Stamp & File Number

4. Lot No. _____, Recorded Plat _____
5. Private Claims _____

	A	B	C	D	E	F	G	H	I	J	K	L	M
2	6		5		4		3		2		1		
3													
4	7		8		9		10		11		12		
5													
6	18		17		16		15		14		13		
7													
8	19		20		21		22		23		24		
9													
10	30		29		28		27		26		25		
11													
12	31		32		33		34		35		36		
13													

I, R. W. CRAMPTON, in a field survey on OCTOBER 30, 19 81, do hereby certify that under requirements of P.A. 74, Michigan P.A. of 1970, the corner points mentioned in lines 1 and 2 above were in conformance with regulations and rules therefore as required in the current manual of survey instructions of the United States Department of the Interior, Bureau of Land Management or by a decree of a Court of Law and/or that the corner points mentioned in lines 3, 4 and 5 above were in conformance with the rules of the Michigan Board of Professional Surveyors or by a Decree of a Court of Law; established, re-established, monumented, re-monumented, recovered, found as expressed below:

NOTE: Not more than 4 corners, all in the same town and range, may be recorded on this certificate.

A. Description of original monument and accessories and/or subsequent restoration:

1-9 POST - 12" MAPLE S40E 4, 10" HEMLOCK N70W 27, NOTHING FOUND.


B. Description of corner evidence found and/or method applied in restoring or reestablishing corner:

1-9 2" SOLID IRON ROD IN BROKEN CONCRETE IN CENTERLINE OF OLD TRAIL

C. Description of monument for corner and accessories established to perpetuate locating the position of the corner:

1-9 THE 2" SOLID IRON ROD WITH 4" BRASS CAP WAS WITNESSED WITH P.K. NAILS NAILED TO: 12" TWIN MAPLE TREE N70W 16.11; 4" MAPLE TREE S3W 8.47; 4" MAPLE TREE S75E 18.61', AND SURVEY TAG NAILED TO 24" OAK TREE N25E 12.35'.

Ratified by Peer Group
In accordance with P.A. 345
Co. Rep. James M. Hobbs
Date 10/15/96

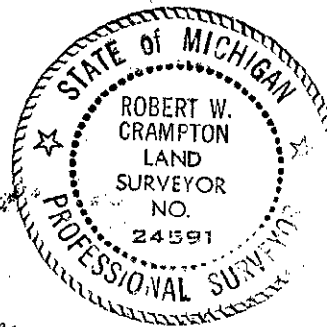

Signed by Robert W. Crampton

Date NOV 1, 1996

Surveyor's Michigan License No. 24591