LAND CORNER RECORDATION CERTIFICATE
Filing Requirement of Act 74, Mich. P.A. 1970 as Amended

For corners in

Keweenaw
(County)

	Located In:		Corner Code #
1. Public Land Survey		T 57N R 32W	B4
		T R	
		T R	
	S	T R	
2. Property Controlling	S 6	T 57N R 32W	12
in Section	S	T R	
3. Miscellaneous	S	T R	
Property in Sec.	S	T R	

Register of Deeds Stamp & File Number

4. Lot No. _____ , Recorded Plat_____

5. Private Claims

B4 Jan 09 2006
12 Jan 04 2006

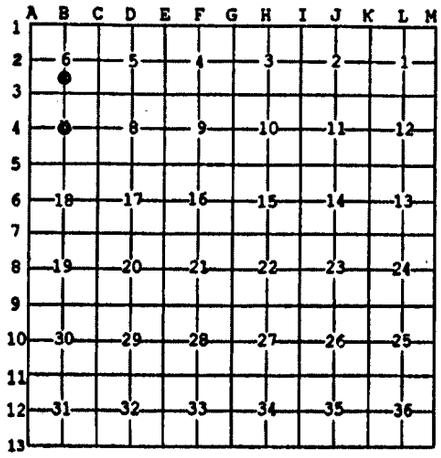

I, Stephan J. Szyszkoski, in a field survey on _____, 20 ____ do hereby state that under requirements of P.A. 74, Michigan P.A. of 1970, the corner points mentioned in lines 1 and 2 above were in conformance with regulations and rules therefore as required in the current manual of survey instructions of the United States Department of the Interior, Bureau of Land Management or by a decree of a Court of Law and /or that the corner points mentioned in lines 3, 4 and 5 above were in conformance with the rules of the Michigan Board of Land Surveyors or by a Decree of a Court of Law; established, re-established, monumented, recovered, found as expressed below:

NOTE: Not more than 2 corners, all in the same town and range, may be recorded on this certificate.

A. Description of original monument and accessories and/or subsequent restoration:

(B4) Center of Section 7. Not established in the original survey.
(12-Sec. 6) South 1/16 corner, Section 6. Not established in the original survey.

B. Description of corner evidence found and/or method applied in restoring or reestablishing corner:

(B4) Established the corner at the intersection of straight lines connecting opposite 1/4 corners.
(12-Sec. 6) Established the corner midway and on a straight line between Quarter corner 1314.18' South and Center of Section 6 1314.18' North.

C. Description of monument for corner and accessories established to perpetuate locating the position of the corner:

(B4) Set 1"IDx32" I.pipe with 4" alum. MDNR cap. Set measuring nails in:

4" Cedar N58E 23.9'	mrkd "C1/4 BT"
6" Cedar S05E 12.7'	do
4" Cedar S25W 13.7'	do
6" Cedar N36W 16.9'	do

Set sq'd cedar post adjacent. Bearings are magnetic. Distances are to nail with tag.

(12) Set 1"IDx32" I.pipe with 4" alum. MDNR cap. Set measuring nails in:

8" Y.Birch North 15.0'	mrkd "1/16S BT"
10" Maple S17E 32.1'	do
5" Cedar S34W 24.1'	do
9" Maple N76W 22.7'	do

Set sq'd cedar post adjacent. Bearings are magnetic. Distances are to nail with tag.

STATE OF MICHIGAN
STEPHAN J. SZYSZKOSKI
LAND SURVEYOR
No. 33986
LICENSED LAND SURVEYOR

Signed by Stephan J. Szyszkoski Date 6/28/06

Surveyor's Michigan License No. 33986

For the Michigan Department of Natural Resources, Office of Land and Facilities

FORM APPROVED BY MICHIGAN STATE BOARD OF PROFESSIONAL SURVEYORS, JAN. 28, 1971
Revised May 14, 1975
Revised Jan., 1983
Revised Oct., 1995