LAND CORNER RECORDATION CERTIFICATE
Filing Requirement of Act 74, Mich. P.A. 1970 as Amended

For corners in

Keweenaw (County)

	Located In:	Corner Code #
1. Public Land Survey	T 57N R 32W	E1
	T___ R___	
	T___ R___	
	S___ T___ R___	
2. Property Controlling	S 6 T 57N R 32W	6
in Section	S___ T___ R___	
3. Miscellaneous	S___ T___ R___	
Property in Sec.	S___ T___ R___	

Register of Deeds Stamp & File Number

4. Lot No. _____ , Recorded Plat_____

5. Private Claims

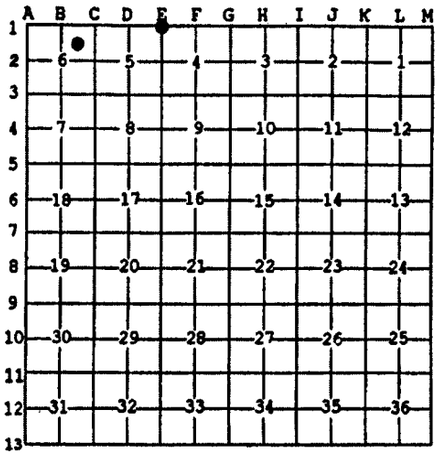

Apr 25 2006

I, Stephan J. Szyszkoski, in a field survey on _____, 20 ____ do hereby state that under requirements of P.A. 74, Michigan P.A. of 1970, the corner points mentioned in lines 1 and 2 above were in conformance with regulations and rules therefore as required in the current manual of survey instructions of the United States Department of the Interior, Bureau of Land Management or by a decree of a Court of Law and /or that the corner points mentioned in lines 3, 4 and 5 above were in conformance with the rules of the Michigan Board of Land Surveyors or by a Decree of a Court of Law; established, re-established, monumented, recovered, found as expressed below:

NOTE: Not more than 2 corners, all in the same town and range, may be recorded on this certificate.

A. Description of original monument and accessories and/or subsequent restoration:

(E1) Corner common to Sections 4-5 T57N-R32W and Sections 32-33 T58N-R32W. 1994: Recovered by John I. Haataja PS 19833 and ratified by Keweenaw County Peer Group in accordance with P.A. 345. Recorded in Liber 1 of LCR, Page 115, Keweenaw County records.
(6-Sec. 6) Northeast 1/16 corner, Section 6. Not established in the original survey. Previously established by John I. Haataja PS 19833 during a subdivision of Section 6.

B. Description of corner evidence found and/or method applied in restoring or reestablishing corner:

(E1) Recovered the 1994 monument, a 1"ID iron pipe with brass cap, in good condition and at record bearing and distance from all 4 1994 witness trees. All but the W.Birch S06W are either dead, down, or have been cut. The W.Birch is nearly dead. Left the monument in place and made 4 new witnesses, as described below.
(6-Sec. 6) Found and accepted a 3/4" ID iron pipe with no cap, in good condition, and in accord with Mr. Haataja's subdivsion of Section 6 as depicted on a sketch located at the offices of the former Lake Superior Land Company in Calumet, MI as follows: 1307.77' north of 1/16 corner #9 (rec. as 1307.83') and 1322.25' west of 1/16 corner #7 (rec. as 1322.27'). Drove a plastic cap stamped "MICH DNR PS 33986" atop the pipe.

C. Description of monument for corner and accessories established to perpetuate locating the position of the corner:

(E1) Found 1"ID I.pipe with brass cap. Set measuring nails in:
7" Cedar N03E 20.9' mrkd "S33 NBT"
11" Cedar S79E 44.8' "S4 NBT"
10" Cedar S12W 65.6' "S5 NBT"
7" Sugar N57W 28.1' "S32 NBT"
Set sq'd cedar post adjacent. Bearings are magnetic. Distances are to nail with tag.

(6) Fd. 3/4" ID I.pipe. Drove plastic cap atop. Set measuring nails in:
11" Maple S16E 13.5' mrkd "1/16S BT"
8" Balsam N88W 19.2' do
4" Balsam N18W 6.5' do
6" Balsam N69E 12.1' do
A metal fence post is N18W 1.0'. Set a sq'd cedar post adjacent. Bearings are magnetic. Distances are to nail with tag.

STATE OF MICHIGAN
STEPHAN J. SZYSZKOSKI
LAND SURVEYOR
No. 33986
LICENSED LAND SURVEYOR

Signed by Stephan J. Szyszkoski Date 6/28/06

Surveyor's Michigan License No. 33986

For the Michigan Department of Natural Resources, Office of Land and Facilities

FORM APPROVED BY MICHIGAN STATE BOARD OF PROFESSIONAL SURVEYORS, JAN. 28, 197
Revised May 14, 197
Revised Jan., 198
Revised Oct., 199