

LAND CORNER RECORDATION CERTIFICATE
Filing Requirement of Act 74, Mich. P.A. 1970 as Amended

For corners in

<u>Keweenaw</u> (County)	Located In:	Corner Code #
1. Public Land Survey	T ___ R ___ T ___ R ___ T ___ R ___	_____ _____ _____
2. Property Controlling in Section	S ___ T ___ R ___ S 6 T 57N R 32W S 6 T 57N R 32W	_____ 9 7
3. Miscellaneous Property in Sec.	S ___ T ___ R ___ S ___ T ___ R ___	_____ _____

Register of Deeds Stamp & File Number

4. Lot No. _____, Recorded Plat _____
 5. Private Claims

Apr 25 2006

I, Stephan J. Szyszkoski, in a field survey on _____, 20____ do hereby state that under requirements of P.A. 74, Michigan P.A. of 1970, the corner points mentioned in lines 1 and 2 above were in conformance with regulations and rules therefore as required in the current manual of survey instructions of the United States Department of the Interior, Bureau of Land Management or by a decree of a Court of Law and /or that the corner points mentioned in lines 3, 4 and 5 above were in conformance with the rules of the Michigan Board of Land Surveyors or by a Decree of a Court of Law; established, re-established, monumented, recovered, found as expressed below:

NOTE: Not more than 2 corners, all in the same town and range, may be recorded on this certificate.

A. Description of original monument and accessories and/or subsequent restoration:


- (9-Sec. 6) East 1/16 corner, Section 6. Not established in the original survey. Previously established by John I. Haataja, PS 19883, date unknown.
- (7-Sec. 6) North 1/16 corner between Sections 5 and 6. Not established in the original survey. Previously established by John I. Haataja PS 19833 during a subdivision of Section 6.

B. Description of corner evidence found and/or method applied in restoring or reestablishing corner:

- (9-Sec. 6) Found and accepted a 3/4" ID iron pipe with plastic cap stamped "LLS19833 J. Haataja". The position of the monument is in accord with Mr. Haataja's subdivision of Section 6 as depicted on a sketch located at the offices of the former Lake Superior Land Company in Calumet, MI. The monument was found 1317.31' East of the Center of Section 6 (rec. as 1317.16') and 1307.77' South of the monumented NE1/16 corner of Section 6 (rec. as 1307.83').
- (7-Sec. 6) Found and accepted a 3/4" ID iron pipe with plastic cap stamped "LLS 19833 J.Haataja" in good condition. The position of the monument is in accord with Mr. Haataja's subdivision of Section 6 as depicted on a sketch located at the offices of the former Lake Superior Land Company in Calumet, MI as follows: 1347.22' South of Section corner C1 (rec. as 1347.13'), and 1322.25' East of 1/16 corner #6 (rec. as 1322.27').

C. Description of monument for corner and accessories established to perpetuate locating the position of the corner:

- | | |
|--|--|
| (9) Found 3/4" I.pipe with plastic cap. | (7) Found 3/4" I.pipe with plastic cap. |
| Set measuring nails in: | Set measuring nails in: |
| 3" Cedar S86W 7.6' mrkd "1/16S BT" | 13" Y.Birch S41W 22.8' mrkd "1/16S BT" |
| 7" Cedar N36W 21.9' do | 7" Maple S59W 34.1' do |
| 6" Maple N51E 7.8' do | 9" Y.Birch N45W 41.5' do |
| 5" Sugar S85E 24.3' do | 12" Y.Birch N73E 28.0' do |
| Set sq'd cedar post adjacent. Bearings are magnetic. Distances are to nail with tag. | Set sq'd cedar post adjacent. Bearings are magnetic. Distances are to nail with tag. |

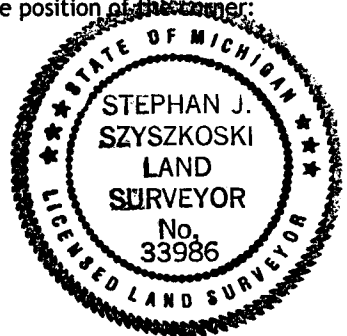

Signed by Stephan J. Szyszkoski
 Surveyor's Michigan License No. 33986

Date 6/28/06

For the Michigan Department of Natural Resources, Office of Land and Facilities