

DEC 16 1998

LAND CORNER RECORDATION CERTIFICATE SECTION  
Filing Requirement of Act 74, Mich. P.A. 1970

For corners in  
Keweenaw  
(County)

Located In:

Corner Code #

- 1. Public Land Survey T 57 R 33
- 2. Property Controlling in Section S \_\_\_\_\_ T \_\_\_\_\_ R \_\_\_\_\_
- 3. Miscellaneous Property in Sec. S \_\_\_\_\_ T \_\_\_\_\_ R \_\_\_\_\_

E-13

REGISTER'S OFFICE, SS  
County of Keweenaw }  
Received for Record, the 4<sup>th</sup>  
day of December A. D. 1998  
at 11:00 o'clock A. M., and Recorded  
in Liber 1 of LCR  
on page 185  
Marilyn Wenquist  
Register of Deeds Stamp & File Number

- 4. Lot No. \_\_\_\_\_, Recorded Plat \_\_\_\_\_
- 5. Private Claims \_\_\_\_\_

	A	B	C	D	E	F	G	H	I	J	K	L	M
2	6	5	4	3	2	1							
3													
4	7	8	9	10	11	12							
5													
6	18	17	16	15	14	13							
7													
8	19	20	21	22	23	24							
9													
10	30	29	28	27	26	25							
11													
12	31	32	33	34	35	36							
13													

I, John I. Haataja, in a field survey on 11/30, 19 98, do hereby certify that under requirements of P.A. 74, Michigan P.A. of 1970, the corner points mentioned in lines 1 and 2 above were in conformance with regulations and rules therefore as required in the current manual of survey instructions of the United States Department of the Interior, Bureau of Land Management or by a decree of a Court of Law and/or that the corner points mentioned in lines 3, 4 and 5 above were in conformance with the rules of the Michigan Board of Land Surveyors or by a Decree of a Court of Law; established, re-established, monumented, re-monumented, recovered, found as expressed below:

**NOTE: Not more than 4 corners, all in the same town and range, may be recorded on this certificate.**


A. Description of original monument and accessories and/or subsequent restoration:  
E-13 Section corner for Section 32&33, T57N-R33W.  
Wood post set by Samuel Hill in 1846  
  
Reference: 7" Fir N28°E 20 lks.  
7" Cedar N52°W 20 lks.

B. Description of corner evidence found and/or method applied in restoring or reestablishing corner:  
E-13 Found 1 1/4" iron pin in concrete set by Holland in 1917.

Ratified by Peer Group  
In accordance with P.A. 345  
Co. Rep. James M. Hill  
Date 12/3/98

C. Description of monument for corner and accessories established to perpetuate locating the position of the corner:  
E-13 Established a witness corner 17.02 feet West of Section corner. Set a 1" pipe with a 4" brass cap stamped with Keweenaw County Remonumentation Point.

Reference: 1 1/2" iron pin in concrete East 17.02'  
6" W. Birch N50°E 13.05'  
10" Spruce S33°W 21.10'  
10" R. Maple N60°W 93.75'

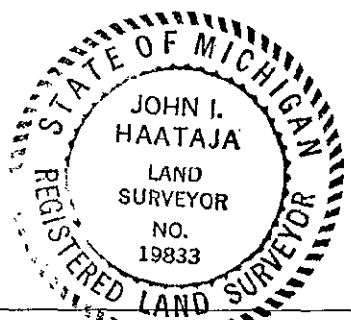

Signed by John I. Haataja  
Surveyor's Michigan License No. 19833

Date 12/2/98