

KEWEENAW COUNTY REMONUMENTATION
 LAND CORNER RECORDATION CERTIFICATE
 Filing Requirement of Act 74, Mich. P.A. 1970

**SURVEY &
 REMONUMENTATION**

APR 28 1995

COMMISSION

KEWEENAW COUNTY REMONUMENTATION
 LAND CORNER RECORDATION CERTIFICATE
 Filing Requirement of Act 74, Mich. P.A. 1970

For corners in

| | | |
|---------------------------------------|----------------------------|----------------|
| <u>Keweenaw</u> (County) | Located In: | Corner Code #1 |
| 1. Public Land Survey | T 57N R 33W T 57N R 33W | I-11 J-11 ✓ |
| 2. Property Controlling in Section | S _____ T _____ R _____ | _____ |
| 3. Miscellaneous Property in Sec. | S _____ T _____ R _____ | _____ |
| 4. Lot No. _____, Recorded Plat _____ | | |
| 5. Private Claims _____ | | |

REGISTER'S OFFICE
 County of Keweenaw } SS th
 Received for Records, the 20
 day of January A.D. 1995
 at 10:30 o'clock A.M., and Recorded
 in Liber 1 of LCR
 on page 136
Maury W. Wainwright
 Register of Deeds

Register of Deeds Stamp & File Number

| | | | | | | | | | | | | | |
|----|----|----|----|----|----|----|---|---|---|---|---|---|---|
| | A | B | C | D | E | F | G | H | I | J | K | L | M |
| 2 | 6 | 5 | 4 | 3 | 2 | | | | | | | | |
| 3 | | | | | | | | | | | | | |
| 4 | 7 | 8 | 9 | 10 | 11 | 12 | | | | | | | |
| 5 | | | | | | | | | | | | | |
| 6 | 18 | 17 | 16 | 15 | 14 | 13 | | | | | | | |
| 7 | | | | | | | | | | | | | |
| 8 | 19 | 20 | 21 | 22 | 23 | 24 | | | | | | | |
| 9 | | | | | | | | | | | | | |
| 10 | 30 | 29 | 28 | 27 | 26 | 25 | | | | | | | |
| 11 | | | | | | | | | | | | | |
| 12 | 31 | 32 | 33 | 34 | 35 | 36 | | | | | | | |
| 13 | | | | | | | | | | | | | |

I, Steven C. Hein, in a field survey on November 9, 1993, do hereby certify that under requirements of P.A. 74, Michigan P.A. of 1970, the corner points mentioned in lines 1 and 2 above were in conformance with regulations and rules theretore as required in the current manual of survey instructions of the United States Department of the Interior, Bureau of Land Management or by a decree of a Court of Law and/or that the corner points mentioned in lines 3, 4 and 5 above were in conformance with the rules of the Michigan Board of Land Surveyors or by a Decree of a Court of Law; established, re-established, monumented, re-monumented, recovered, found as expressed below:

NOTE: Not more than 4 corners, all in the same town and range, may be recorded on this certificate.


A. Description of original monument and accessories and/or subsequent restoration:

- (I-11) NW Cor. Sec. 35: Set post corner of Sections 26-27-34 & 35 Sugar 6 S20W 33, Do 14 N20E 46. Original corner not found. 1 1/2" pipe, 34" A.G. at fence cor. (N,E & W) was found and accepted in Sept., 1991 survey by C.E.Hein, P.S.
- (J-11) N 1/4 Cor. Sec. 35: 39.87 Set post Quarter Section corner Cedar 10 S41E 34, Sugar 13 N70W 10 Original corner not found. 1/2" capped pin was set by C.E. Hein, P.S. in Sept., 1991 survey at proportional distance between NW & NE Corners of Section 35

B. Description of corner evidence found and/or method applied in restoring or reestablishing corner:

- (I-11) NW Cor. Sec. 35: Found 1 1/2" pipe at fence corner. Found witnesses with face blaze and side blaze with nail & tag #13034: 6" H.Maple N47°E 11.08'; 5" Oak S40°E 45.44'; 18" Twin Oak S28°W 25.12'; 6" H.Maple N48°W 6.53'
- (J-11) N 1/4 Cor. Sec. 35: Found 1/2" capped pin, #13034, 8" B.G. 6' North of E road, corner fits well with fence to South. Found witnesses face blaze and side blaze with nail & tag #13034: 7" Cedar 46.04'; 8" W.Birch S25E 29.16'; 6" W.Birch S36°W 46.14'

Ratified by Peer Group
 In accordance with P.A. 345
 Co. Rep. [Signature]
 Date 10/28/1993

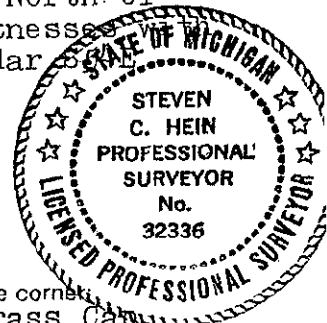

C. Description of monument for corner and accessories established to perpetuate locating the position of the corner:

- (I-11) NW Cor. Sec. 35: Replace 1 1/2" pipe with 1" pipe and 4" Brass Cap stamped "KEWEENAW COUNTY REMONUMENTATION POINT" T57N-R33W, S27, S26, S34 & S35, P.S. 32336. Witnesses as shown in section B above.
- (J-11) N 1/4 Cor. Sec. 35: Replaced 1/2" capped pin with 1" pipe and 4" Brass Cap, 6" B.G. 6' North of E gravel road, stamped KEWEENAW COUNTY REMONUMENTATION POINT" T57N-R33W, 1/4, S26/S35, P.S. 32336. Witnesses as shown in section B above. One new witness with face blaze and side blaze with nail & tag #32336: 3" Oak N24°W 33.83'