SURVEY & REMONUMENTATION

APR 28 1995

COMMISSION

LAND CORNER RECORDATION CERTIFICATE

Filing Requirement of Act 74, Mich. P.A. 1970

For corners in Keweenaw (County)

	Located In:	Corner Code ##
1. Public Land Survey	T 57N R 33W	M-3
	T ___ R ___	
	T ___ R ___	
	T ___ R ___	
2. Property Controlling	S ___ T ___ R ___	
in Section	S ___ T ___ R ___	
3. Miscellaneous	S ___ T ___ R ___	
Property in Sec.	S ___ T ___ R ___	

REGISTER'S OFFICE
County of Keweenaw } SS
Received for Record, the 15th day of December A.D. 1994 at 3:00 o'clock P.M., and Recorded in Liber 1 of LCR on page 121
Marilyn Wiegand
Register of Deeds

Register of Deeds Stamp & File Number

4. Lot No. _____, Recorded Plat _____
5. Private Claims _____

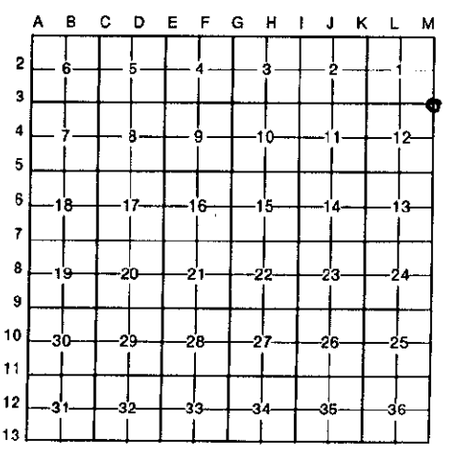

I, John I. Haataja, in a field survey on June 24, 19 93, do hereby certify that under requirements of P.A. 74, Michigan P.A. of 1970, the corner points mentioned in lines 1 and 2 above were in conformance with regulations and rules therefore as required in the current manual of survey instructions of the United States Department of the Interior, Bureau of Land Management or by a decree of a Court of Law and/or that the corner points mentioned in lines 3, 4 and 5 above were in conformance with the rules of the Michigan Board of Land Surveyors or by a Decree of a Court of Law; established, re-established, monumented, re-monumented, recovered, found as expressed below:

NOTE: Not more than 4 corners, all in the same town and range, may be recorded on this certificate.

A. Description of original monument and accessories and/or subsequent restoration:

M-3 Sec. Corner 6 & 7, T57N-R32W and 1 & 12, T57N-R33W.
Orig. Notes: Wood Post for corner.
Spruce 6" S 80° W 29 lks.
Spruce 6" N 7° E 16 lks.
Keweenaw Land Assn. records show corner as 10" Aspen with location tag dated 1974.

B. Description of corner evidence found and/or method applied in restoring or reestablishing corner:

M-3 Sec. Corner 6 & 7, T57N-R32W and 1 & 12, T57N-R33W.
Found location tag on 10" Aspen with lines blazed in three directions. Restored corner at 10" Aspen tree.

Ratified by Peer Group
In accordance with P.A. 345
Co. Rep. James Hubbl
Date 11/16/94

C. Description of monument for corner and accessories established to perpetuate locating the position of the corner:

M-3 Sec. Corner 6 & 7, T57N-R32W and 1 & 12, T57N-R33W.
Set 1" iron pipe with brass cap as a careful and faithful perpetuation of the position of the original corner.

12" Poplar	South	1.18'
10" Poplar	N 51° E	17.16'
12" W. Birch	N 1° W	29.40'
5" H. Maple	S 80° W	16.74'

STATE OF MICHIGAN
JOHN I. HAATAJA
LAND SURVEYOR
NO. 19833
REGISTERED LAND SURVEYOR

Signed by John I. Haataja Date November 23, 1994

Surveyor's Michigan License No. 19833

FORM APPROVED BY MICHIGAN STATE BOARD OF LAND SURVEYORS, JAN. 28, 1971
REVISED MAY 14, 1975
REVISED JAN., 1983