

SURVEY & REMONUMENTATION

APR 28 1995

COMMISSION

LAND CORNER RECORDATION CERTIFICATE Filing Requirement of Act 74, Mich. P.A. 1970

For corners in

Keweenaw
(County)

Located In:

Corner Code ##

- | | | | | | | |
|---------------------------------------|---|------------|---|------------|---|------------|
| 1. Public Land Survey | T | <u>57N</u> | R | <u>33W</u> | | <u>M-4</u> |
| | T | | R | | | |
| | T | | R | | | |
| | T | | R | | | |
| 2. Property Controlling
in Section | S | | T | | R | |
| | S | | T | | R | |
| 3. Miscellaneous
Property in Sec. | S | | T | | R | |
| | S | | T | | R | |

4. Lot No. _____, Recorded Plat _____
5. Private Claims _____

REGISTER'S OFFICE }
County of Keweenaw } SS
Received for Record, the 20th
day of January A.D. 1995
at 10:30 o'clock A.M., and Recorded
in Liber 1 of LCR
on page 132
Marilyn W. Wierquist
Register of Deeds

Register of Deeds Stamp & File Number

I, John I. Haataja, in a field survey on November 21, 1994, do hereby certify that under requirements of P.A. 74, Michigan P.A. of 1970, the corner points mentioned in lines 1 and 2 above were in conformance with regulations and rules therefore as required in the current manual of survey instructions of the United States Department of the Interior, Bureau of Land Management or by a decree of a Court of Law and/or that the corner points mentioned in lines 3, 4 and 5 above were in conformance with the rules of the Michigan Board of Land Surveyors or by a Decree of a Court of Law; established, re-established, monumented, re-monumented, recovered, found as expressed below:

NOTE: Not more than 4 corners, all in the same town and range, may be recorded on this certificate.

A. Description of original monument and accessories and/or subsequent restoration:

- M-4 1/4 Cor. Between Sec. 7, T57N-R32W and Sec. 12, T57N-R33W.
Orig. Notes set wood post
Maple 8" S 68° E 14 lks.
Hemlock 32" N 52° W 42 lks.

B. Description of corner evidence found and/or method applied in restoring or reestablishing corner:


- M-4 1/4 Cor. Between Sec. 7, T57N-R32W and Sec. 12, T57N-R33W.
No trace of original corner found.
Re-established corner by single proportion between adjacent section corners.

C. Description of monument for corner and accessories established to perpetuate locating the position of the corner:

- M-4 1/4 Cor. Between Sec. 7, T57N-R32W and Sec. 12, T57N-R33W.
Set a 1" iron pipe with brass cap and is a careful and faithful re-establishment of the position of the original corner.
8" Balsam S 48° E 13.31'
10" W. Birch N 47° W 1.12'
12" W. Birch S 30° W 27.97'
12" Maple N 4° E 35.43'

	A	B	C	D	E	F	G	H	I	J	K	L	M
2	6	5	4	3	2	1							
3													
4	7	8	9	10	11	12							
5													
6	18	17	16	15	14	13							
7													
8	19	20	21	22	23	24							
9													
10	30	29	28	27	26	25							
11													
12	31	32	33	34	35	36							
13													

Ratified by Peer Group
In accordance with P.A. 345
Co. Rep. James R. Sahlh
Date 11/16/94

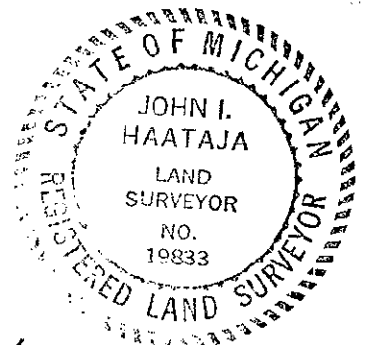

Signed by John I. Haataja
Surveyor's Michigan License No. 19833

Date 12/30/94