

**SURVEY &
REMONUMENTATION**

APR 28 1995

COMMISSION

**LAND CORNER RECORDATION CERTIFICATE
Filing Requirement of Act 74, Mich. P.A. 1970**

For corners in

Keweenaw
(County)

Located In:

Corner Code #

- | | | |
|---------------------------------------|---------------------------|------------|
| 1. Public Land Survey | T <u>57N</u> R <u>33W</u> | <u>M-5</u> |
| | T _____ R _____ | _____ |
| | T _____ R _____ | _____ |
| | T _____ R _____ | _____ |
| 2. Property Controlling in Section | S _____ T _____ R _____ | _____ |
| | S _____ T _____ R _____ | _____ |
| 3. Miscellaneous Property in Sec. | S _____ T _____ R _____ | _____ |
| | S _____ T _____ R _____ | _____ |
| 4. Lot No. _____, Recorded Plat _____ | | |
| 5. Private Claims _____ | | |

REGISTER'S OFFICE

County of Keweenaw } SS
 Received for Record, the 15th
 day of December A.D. 1994
 at 5:00 o'clock P.M., and Recorded
 in Liber 1 of LCR
 on page 122
Manly H. Haggart
 Register of Deeds

Register of Deeds Stamp & File Number

	A	B	C	D	E	F	G	H	I	J	K	L	M
2	6	5	4	3	2	1							
3													
4	7	8	9	10	11	12							
5													
6	18	17	16	15	14	13							
7													
8	19	20	21	22	23	24							
9													
10	30	29	28	27	26	25							
11													
12	31	32	33	34	35	36							
13													

I, John I. Haataja, in a field survey on November 21, 19 94, do hereby certify that under requirements of P.A. 74, Michigan P.A. of 1970, the corner points mentioned in lines 1 and 2 above were in conformance with regulations and rules therefore as required in the current manual of survey instructions of the United States Department of the Interior, Bureau of Land Management or by a decree of a Court of Law and/or that the corner points mentioned in lines 3, 4 and 5 above were in conformance with the rules of the Michigan Board of Land Surveyors or by a Decree of a Court of Law; established, re-established, monumented, re-monumented, recovered, found as expressed below:

NOTE: Not more than 4 corners, all in the same town and range, may be recorded on this certificate.

A. Description of original monument and accessories and/or subsequent restoration:

M-5 Sec. Cor. 7 & 18, T57N-R32W and 12 & 13, T57N-R33W.

Orig. Notes: Wood Post for corner.

Maple 10" S 9½° W 15 lks.

Fir 8" N 14° W 36 lks.

1½ iron pipe was noted at corner during survey for Weglorz in 1985. No record of who set pipe.

B. Description of corner evidence found and/or method applied in restoring or reestablishing corner:

M-5 Sec. Cor. 7 & 18, T57N-R32W and 12 & 13, T57N-R33W.

Found 1½" bent pipe at fence intersection.

Restored corner at pipe location.

C. Description of monument for corner and accessories established to perpetuate locating the position of the corner:

M-5 Sec. Cor. 7 & 18, T57N-R32W and 12 & 13, T57N-R33W.

Set 1" pipe with brass cap as a careful and faithful perpetuation of the position of the original corner.


10" R. Maple N 77° E 8.57'

3" H. Maple S 46° W 5.20'

6" R. Maple N 62° W 10.94'

3" H. Maple N 5° E 36.66'

Ratified by Peer Group
 In accordance with P.A. 345
 Co. Rep. *James Haggart*
 Date 11/16/94

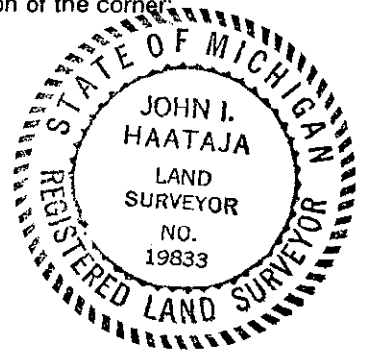

Signed by *John I. Haataja*

Date November 23, 1994

Surveyor's Michigan License No. 19833