

SURVEY & REMONUMENTATION

FEB 07 2001

SECTION LAND CORNER RECORDATION CERTIFICATE
Filing Requirement of Act 74, Mich. P.A. 1970

For corners in KEWEENAW (County) Located In: _____ Corner Code # _____

1. Public Land Survey T 59N R 28W A-12, A-13
 T 59N R 29W M-12, M-13
 T 58N R 29W M-1
 T 58N R 28W A-1

2. Property Controlling in Section S _____ T _____ R _____
 S _____ T _____ R _____


3. Miscellaneous Property in Section S _____ T _____ R _____
 S _____ T _____ R _____

4. Lot No. _____, Recorded Plat _____

5. Private Claims _____

REGISTER'S OFFICE }
 County of Keweenaw } SS
 Received for Record, the 7th
 day of December A.D. 20 00
 at 10:30 o'clock A M., and Recorded
 in Liber 2 of LCR
 on page 6
Julia A. Carlson, Deputy
 Register of Deeds

Register of Deeds Stamp & File Number

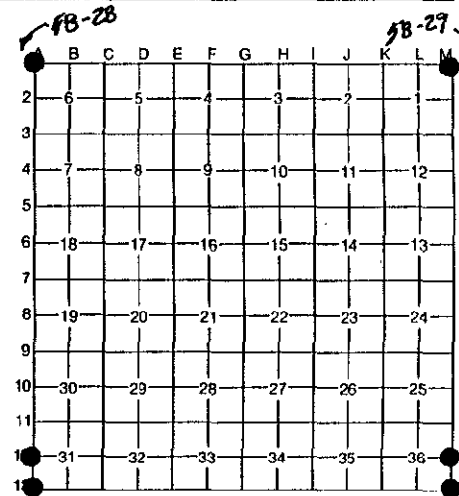

I, R. W. CRAMPTON, in a field survey on November 2000, 49- , do hereby certify that under requirements of P.A. 74, Michigan P.A. of 1970, the corner points mentioned in lines 1 and 2 above were in conformance with regulations and rules therefore as required in the current manual of survey instructions of the United States Department of the Interior, Bureau of Land Management or by a decree of a Court of Law and/or that the corner points mentioned in lines 3, 4 and 5 above were in conformance with the rules of the Michigan Board of Professional Surveyors or by a Decree of a Court of Law; established, re-established, monumented, re-monumented, recovered, found as expressed below:

NOTE: Not more than 4 corners, all in the same town and range, may be recorded on this certificate.

A. Description of original monument and accessories and/or subsequent restoration:


A-12: Post; B. Oak 10" N46°E 31 links, Fir 6" N32°W 13 links (no evidence found).

A-13: Post set for corner of Towns 58 & 59 North, Ranges 28 & 29 West; Sugar 6" N54°E 10 links, Sugar 12" S57°W 40 links (no evidence found).

B. Description of corner evidence found and/or method applied in restoring or reestablishing corner:

A-12: During the course of survey work within Section 31, a diligent search for original GLO or subsequent survey evidence was made. Finding no conclusive evidence, the corner was reestablished midway and on line between the Northwest and Southwest corners of said Section 31 (see LCRC filed in Liber 1, P. 207 on 10/17/99).

A-13: Found 1" drill rod in 2'x2' concrete pad consistent with MDOT US-41 highway notes. Monument accepted as found (see LCRC filed in Liber 1, P.207 on 10/27/99).

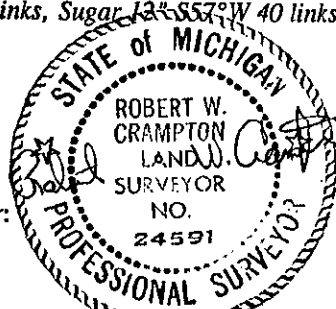

Ratified by Peer Group
 In accordance with P.A. 345
 Co. Rep. [Signature]
 Date 12/4/00

C. Description of monument for corner and accessories established to perpetuate locating the position of the corner:

A-12: At the position so calculated, a 1" iron pipe with a 4" diameter Keweenaw County Remonumentation Point brass cap was set and witnessed with a survey tag, stamped PS 24591, nailed to: 14" Oak tree North 22.03 feet, 8" Oak tree N68°E 9.30 feet, 6" White Birch tree S15°E 30.24 feet, 4" Spruce tree S65°W 11.12 feet.

A-13: Found 1" drill rod capped with a 4" diameter Keweenaw County Remonumentation Point brass cap and witnessed with a survey tag, stamped PS 24591, nailed to: 14" White Pine tree S88°W 12.70 feet, 18" White Pine tree N14°E 20.41 feet, 8" Oak tree N70 °E 44.30 feet, 6" Maple tree S34°E 29.98 feet.

Signed by Robert W. Crampton Date Dec. 1, 2000
 Surveyor's Michigan License No. 24591