

# SURVEY & REMONUMENTATION

MAR 19 1997

## LAND CORNER RECORDATION CERTIFICATE Filing Requirement of Act 74, Mich. P.A. 1970

For corners in **COMMISSION**

Keweenaw <small>(County)</small>	Located In:	Corner Code #
1. Public Land Survey	T 58 R 29	E-4
	T 58 R 29	E-2 ✓
	T _____ R _____	_____
	T _____ R _____	_____
	T _____ R _____	_____
2. Property Controlling in Section	S _____ T _____ R _____	_____
	S _____ T _____ R _____	_____
3. Miscellaneous Property in Sec.	S _____ T _____ R _____	_____
	S _____ T _____ R _____	_____

REGISTER'S OFFICE }  
County of Keweenaw } SS  
Received for Record, the 9<sup>th</sup>  
day of December A.D. 1996  
at 1:00 o'clock P.M. and Recorded  
in Liber 1 of LCR  
on page 160  
Roberta Rosenberger Dyer  
Register of Deeds

Register of Deeds Stamp & File Number

4. Lot No. \_\_\_\_\_, Recorded Plat \_\_\_\_\_  
5. Private Claims \_\_\_\_\_

I, John I. Haatja, in a field survey on September 16, 1996, do hereby certify that under requirements of P.A. 74, Michigan P.A. of 1970, the corner points mentioned in lines 1 and 2 above were in conformance with regulations and rules therefore as required in the current manual of survey instructions of the United States Department of the Interior, Bureau of Land Management or by a decree of a Court of Law and/or that the corner points mentioned in lines 3, 4 and 5 above were in conformance with the rules of the Michigan Board of Land Surveyors or by a Decree of a Court of Law; established, re-established, monumented, re-monumented, recovered, found as expressed below:

	A	B	C	D	E	F	G	H	I	J	K	L
2	8	5	•	4	3	2	1					
3												
4	7	8	•	9	10	11	12					
5												
6	18	17	16	15	14	13						
7												
8	19	20	21	22	23	24						
9												
10	30	29	28	27	26	25						
11												
12	31	32	33	34	35	36						
13												

**NOTE:** Not more than 4 corners, all in the same town and range, may be recorded on this certificate.

**A. Description of original monument and accessories and/or subsequent restoration:**

- |  |  |
|--|--|
| <p>E-4 W-1/4 cor. Sec. 9<br/>Wood Post<br/>Sugar 10" N 40 E 34 1ks.<br/>Sugar 12" S 38 W 20 1ks.</p> | <p>E-2 W-1/4 cor. Sec. 4<br/>Wood Post<br/>No references</p> |
|--|--|


**B. Description of corner evidence found and/or method applied in restoring or reestablishing corner:**

- |   |   |
|---|---|
| <p>E-4 FND. no evidence of orig. cor.<br/>Re-established 1/4 cor. by single proportionate meas. between N.W. and S.W. corners at Sec. 9</p> | <p>E-2 FND. no evidence of original cor.<br/>Old C&amp;H records show a sq. tree. FND. sq. tree rotted down at int. of N-S &amp; E paint lines.<br/>When checked this location proved to be too far South.<br/>Re-established 1/4 cor. by single proportionate measurement between the NW and SW corners of Sec. 4.</p> |
|---|---|

Ratified by Peer Group  
In accordance with P.A. 345  
Co. Rep. James M. Hubbell  
Date 12/6/96

**C. Description of monument for corner and accessories established to perpetuate locating the position of the corner:**

- |   |   |
|---|---|
| <p>E-4 W-1/4 cor. Sec. 9<br/>Set 1" pipe with brass cap<br/>8" Maple S 59 W 14.09'<br/>8" Maple N 54 W 23.75'<br/>14" Maple N 59 E 20.22'<br/>4" Maple S 50 E 6.59'</p> | <p>E-2 W-1/4 cor. of Sec. 4<br/>Set 1" pipe with brass cap<br/>4" Maple S 18 W 17.12'<br/>5" Maple N 60 W 17.39'<br/>5" Maple N 11 E 24.57'<br/>12" Oak S 47 E 17.67'</p> |
|---|---|

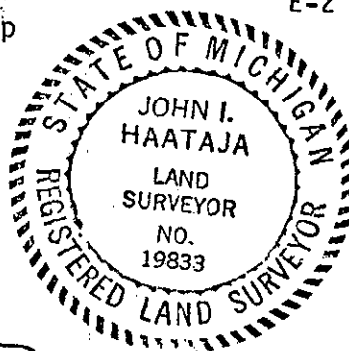

igned by John I. Haatja  
urveyor's Michigan License No. 19833

Date 11/27/96