

SURVEY & REMONUMENTATION

MAR 19 1997

COMMISSION

LAND CORNER RECORDATION CERTIFICATE
Filing Requirement of Act 74, Mich. P.A. 1970

For corners in

Keweenaw
(County)

Located In:

Corner Code #

- | | | |
|---------------------------------------|-------------------------|-------|
| 1. Public Land Survey | T 58 R 29 | E-4 ✓ |
| | T 58 R 29 | E-2 |
| | T _____ R _____ | |
| | T _____ R _____ | |
| 2. Property Controlling in Section | S _____ T _____ R _____ | |
| | S _____ T _____ R _____ | |
| 3. Miscellaneous Property in Sec. | S _____ T _____ R _____ | |
| | S _____ T _____ R _____ | |
| 4. Lot No. _____, Recorded Plat _____ | | |
| 5. Private Claims _____ | | |

REGISTER'S OFFICE }
County of Keweenaw } SS
Received for Record, the 9th
day of December A.D. 1996
at 1:00 o'clock P.M. and Record
in Liber 1 of LCR
on page 160
Roberta Rosenberger
Register of Deeds

Register of Deeds Stamp & File Number

A	B	C	D	E	F	G	H	I	J	K	L
2	6	5	4	3	2						
3											
4	7	8	9	10	11	12					
5											
6	18	17	16	15	14	13					
7											
8	19	20	21	22	23	24					
9											
10	30	29	28	27	26	25					
11											
12	31	32	33	34	35	36					
13											

I, John I. Haatja, in a field survey on September 16, 1996
do hereby certify that under requirements of P.A. 74, Michigan P.A. of 1970, the corner points mentioned in lines 1 and 2 above were in conformance with regulations and rules therefore as required in the current manual of survey instructions of the United States Department of the Interior, Bureau of Land Management or by a decree of a Court of Law and/or that the corner points mentioned in lines 3, 4 and 5 above were in conformance with the rules of the Michigan Board of Land Surveyors or by a Decree of a Court of Law; established, re-established, monumented, re-monumented, recovered, found as expressed below:

NOTE: Not more than 4 corners, all in the same town and range, may be recorded on this certificate.

A. Description of original monument and accessories and/or subsequent restoration:

E-4 W-1/4 cor. Sec. 9
Wood Post
Sugar 10" N 40 E 34 lks.
Sugar 12" S 38 W 20 lks.

E-2 W-1/4 cor. Sec. 4
Wood Post
No references

B. Description of corner evidence found and/or method applied in restoring or reestablishing corner:

E-4 FND. no evidence of orig. cor.
Re-established 1/4 cor. by single proportionate meas. between N.W. and S.W. corners at Sec. 9


E-2 FND. no evidence of original cor.
Old C&H records show a sq. tree. FND. sq. tree rotted down at int. of N-S & E paint lines. When checked this location proved to be too far South. Re-established 1/4 cor. by single proportionate measurement between the NW and SW corners of Sec. 4.

Ratified by Peer Group
In accordance with P.A. 345
Co. Rep. James M. Hebble
Date 12/16/96

C. Description of monument for corner and accessories established to perpetuate locating the position of the corner:

E-4 W-1/4 cor. Sec. 9
Set 1" pipe with brass cap
8" Maple S 59 W 14.09'
8" Maple N 54 W 23.75'
14" Maple N 59 E 20.22'
4" Maple S 50 E 6.59'

E-2 W-1/4 cor. of Sec. 4
Set 1" pipe with brass cap
4" Maple S 18 W 17.12'
5" Maple N 60 W 17.39'
5" Maple N 11 E 24.57'
12" Oak S 47 E 17.67'

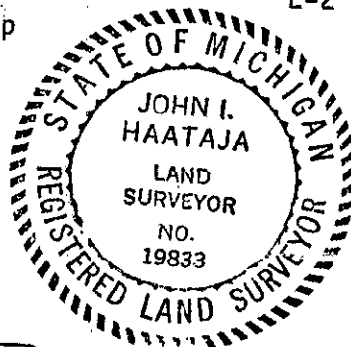

Signed by John I. Haatja
Surveyor's Michigan License No. 19833

Date 11/27/96