

**SURVEY & REMONUMENTATION**

MAR 19 1997

**COMMISSION**

For corners in

Keweenaw

(County)

**LAND CORNER RECORDATION CERTIFICATE**

Filing Requirement of Act 74, Mich. P.A. 1970

REGISTER'S OFFICE }  
County of Keweenaw } SS

Received for Record, the 9<sup>th</sup> day of December A.D. 1996 at 1:00 o'clock P.M., and Recorded in Liber 1 of LCR on page 159  
Roberta Rosenberger  
Register of Deed

Register of Deeds Stamp & File Number

	Located In:	Corner Code #
1. Public Land Survey	T <u>58</u> R <u>29</u>	<u>(F-1)</u> ✓
	T <u>58</u> R <u>29</u>	<u>F-5</u>
	T _____ R _____	_____
	T _____ R _____	_____
2. Property Controlling in Section	S _____ T _____ R _____	_____
	S _____ T _____ R _____	_____
3. Miscellaneous Property in Sec.	S _____ T _____ R _____	_____
	S _____ T _____ R _____	_____

4. Lot No. \_\_\_\_\_, Recorded Plat \_\_\_\_\_  
5. Private Claims \_\_\_\_\_

I, John I. Haataja, in a field survey on September 26, 19 96 do hereby certify that under requirements of P.A. 74, Michigan P.A. of 1970, the corner points mentioned in lines 1 and 2 above were in conformance with regulations and rules therefore as required in the current manual of survey instructions of the United States Department of the Interior, Bureau of Land Management or by a decree of a Court of Law and/or that the corner points mentioned in lines 3, 4 and 5 above were in conformance with the rules of the Michigan Board of Land Surveyors or by a Decree of a Court of Law; established, re-established, monumented, re-monumented, recovered, found as expressed below:

	A	B	C	D	E	F	G	H	I	J	K	L
2	6	5	4	3	2							
3												
4	7	8	9	10	11	12						
5												
6	16	17	16	15	14	13						
7												
8	19	20	21	22	23	24						
9												
10	30	29	28	27	26	25						
11												
12	31	32	33	34	35	36						
13												

**NOTE: Not more than 4 corners, all in the same town and range, may be recorded on this certificate.**

A. Description of original monument and accessories and/or subsequent restoration:

- |  |  |
|--|--|
| F-1 N-1/4 cor. Sec. 4<br>Wood Post<br>Fir 7" N 78 E 31 lks.<br>Fir 6" N 14 W 11 lks. | F-5 S-1/4 cor. Sec. 9<br>Wood Post<br>Sugar 10" S 14 E 60 lks.<br>Sugar 12" N 20 W 43 lks. |
|--|--|


B. Description of corner evidence found and/or method applied in restoring or reestablishing corner:

- |  |  |
|--|--|
| F-1 No evidence of any corner found.<br>Re-established by single proportionate measurement between NW and NE corners of Sec. 4 | F-5 No evidence of corner FND.<br>Re-established by single proportionate measurement between SW & SE corners of Sec. 9 |
|--|--|

Ratified by Peer Group  
In accordance with P.A. 345  
Co. Rep. James M. Haataja  
Date 12/6/96

C. Description of monument for corner and accessories established to perpetuate locating the position of the corner:

- |   |   |
|---|---|
| F-1 N-1/4 corner of Sec. 4<br>Set 1" pipe with brass cap<br>8" Ironwood N 76 E 13.07'<br>6" B. Fir S 23 W 4.70'<br>14" Cedar N 50 W 3.68'<br>4" Maple N 50 E 12.41' | F-5 S-1/4 corner Sec. 9<br>Set 1" pipe with brass cap<br>4" Maple N 27 E 8.53'<br>3" Maple S 80 E 14.15'<br>4" Maple S 22 W 8.95'<br>5" Maple N 77 W 22.30' |
|---|---|

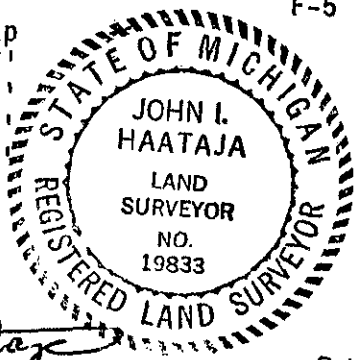

Drawn by John I. Haataja Date 4/27/96  
Surveyor's Michigan License No. 19833