

SURVEY & REMONUMENTATION

MAR 19 1997

COMMISSION

LAND CORNER RECORDATION CERTIFICATE Filing Requirement of Act 74, Mich. P.A. 1970

For corners in

<u>Keweenaw</u> <small>(County)</small>	Located In:	Corner Code #
1. Public Land Survey	T <u>58</u> R <u>29</u>	F-1
	T <u>58</u> R <u>29</u>	<u>F-5</u> ✓
	T _____ R _____	_____
	T _____ R _____	_____
2. Property Controlling in Section	S _____ T _____ R _____	_____
	S _____ T _____ R _____	_____
3. Miscellaneous Property in Sec.	S _____ T _____ R _____	_____
	S _____ T _____ R _____	_____
4. Lot No. _____, Recorded Plat _____		
5. Private Claims _____		

REGISTER'S OFFICE }
County of Keweenaw } SS
Received for Record, the 9th
day of December A.D. 1996
at 1:00 o'clock P.M., and Recorded
in Liber 1 of LCR
on page 159
Roberta Rosenberger, D.P.S.
Register of Deeds

Register of Deeds Stamp & File Number

I, John I. Haataja, in a field survey on September 26, 1996
do hereby certify that under requirements of P.A. 74, Michigan P.A. of 1970, the corner points mentioned
in lines 1 and 2 above were in conformance with regulations and rules therefore as required in the
current manual of survey instructions of the United States Department of the Interior, Bureau of Land
Management or by a decree of a Court of Law and/or that the corner points mentioned in lines 3, 4 and 5
above were in conformance with the rules of the Michigan Board of Land Surveyors or by a Decree of a
Court of Law; established, re-established, monumented, re-monumented, recovered, found as
expressed below:

	A	B	C	D	E	F	G	H	I	J	K	L
2	6	5	4	3	2	1						
3												
4	7	8	9	10	11	12						
5												
6	18	17	16	15	14	13						
7												
8	19	20	21	22	23	24						
9												
10	30	29	28	27	26	25						
11												
12	31	32	33	34	35	36						
13												

NOTE: Not more than 4 corners, all in the same town and range, may be recorded on this certificate.

A. Description of original monument and accessories and/or subsequent restoration:

- | | |
|--|--|
| <p>F-1 N-1/4 cor. Sec. 4
Wood Post
Fir 7" N 78 E 31 lks.
Fir 6" N 14 W 11 lks.</p> | <p>F-5 S-1/4 cor. Sec. 9
Wood Post
Sugar 10" S 14 E 60 lks.
Sugar 12" N 20 W 43 lks.</p> |
|--|--|


B. Description of corner evidence found and/or method applied in restoring or reestablishing corner:

- | | |
|--|--|
| <p>F-1 No evidence of any corner found.
Re-established by single proportionate
measurement between NW and NE corners
of Sec. 4</p> | <p>F-5 No evidence of corner FND.
Re-established by single propor-
tionate measurement between SW &
SE corners of Sec. 9</p> |
|--|--|

Ratified by Peer Group
In accordance with P.A. 345
Co. Rep. James N. Haataja
Date: 12/6/96

C. Description of monument for corner and accessories established to perpetuate locating the position of the corner:

- | | |
|---|---|
| <p>F-1 N-1/4 corner of Sec. 4
Set 1" pipe with brass cap
8" Ironwood N 76 E 13.07'
6" B. Fir S 23 W 4.70'
14" Cedar N 50 W 3.68'
4" Maple N 50 E 12.41'</p> | <p>F-5 S-1/4 corner Sec. 9
Set 1" pipe with brass cap
4" Maple N 27 E 8.53'
3" Maple S 80 E 14.15'
4" Maple S 22 W 8.95'
5" Maple N 77 W 22.30'</p> |
|---|---|

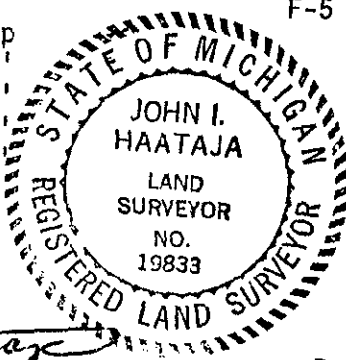

Witnessed by John I. Haataja Date 11/27/96
Surveyor's Michigan License No. 19833