

# SURVEY & REMONUMENTATION

MAR 19 1997

COMMISSION

## LAND CORNER RECORDATION CERTIFICATE Filing Requirement of Act 74, Mich. P.A. 1970

For corners in

Keweenaw  
(County)

Located In:

Corner Code #

- |                                       |   |     |   |     |       |
|---------------------------------------|---|-----|---|-----|-------|
| 1. Public Land Survey                 | T | 58N | R | 29W | G-1 ✓ |
|                                       | T | 58N | R | 29W | E-1   |
|                                       | T |     | R |     |       |
|                                       | T |     | R |     |       |
| 2. Property Controlling in Section    | S |     | T | R   |       |
|                                       | S |     | T | R   |       |
| 3. Miscellaneous Property in Sec.     | S |     | T | R   |       |
|                                       | S |     | T | R   |       |
| 4. Lot No. _____, Recorded Plat _____ |   |     |   |     |       |
| 5. Private Claims _____               |   |     |   |     |       |

REGISTER'S OFFICE }  
County of Keweenaw } SS  
Received for Record, the 9th  
day of December A.D. 1996  
at 1:00 o'clock P.M., and Recorded  
in Liber 1 of LCR  
on page 158  
Roberta Rosenberger, Deputy  
Register of Deeds

Register of Deeds Stamp & File Number

	A	B	C	D	E	F	G	H	I	J	K	L
2	6	5	4	3	2	1						
3												
4	7	8	9	10	11	12						
5												
6	13	17	16	15	14	13						
7												
8	19	20	21	22	23	24						
9												
10	30	29	28	27	26	25						
11												
12	31	32	33	34	35	36						
13												

I, John I. Haataja, in a field survey on September 15, 1996  
do hereby certify that under requirements of P.A. 74, Michigan P.A. of 1970, the corner points mentioned in lines 1 and 2 above were in conformance with regulations and rules therefore as required in the current manual of survey instructions of the United States Department of the Interior, Bureau of Land Management or by a decree of a Court of Law and/or that the corner points mentioned in lines 3, 4 and 5 above were in conformance with the rules of the Michigan Board of Land Surveyors or by a Decree of a Court of Law; established, re-established, monumented, re-monumented, recovered, found as expressed below:

**NOTE: Not more than 4 corners, all in the same town and range, may be recorded on this certificate.**

A. Description of original monument and accessories and/or subsequent restoration:

G-1 NE cor. Sec. 4  
Wood Post  
Cedar 14" N 51° E 19 lks.  
Cedar 8" N 30° W 28 lks.

E-1 NW cor. Sec. 4  
Wood Post  
Sugar 7" N 12° E 26 lks.  
Sugar 7" N 35° W 30 lks.

B. Description of corner evidence found and/or method applied in restoring or reestablishing corner:


G-1 Found original B.T. Cedar NE with scribes laying down. Found other BT stump. Re-established corner from BTs.

E-1 Found 2 Cedar BT's not original. Old C&H notes call for square Cedar for corner. Re-established corner from Cedar BTs.

Ratified by Peer Group  
In accordance with P.A. 345  
Co. Rep. James M. Hubbs  
Date 12/6/96

C. Description of monument for corner and accessories established to perpetuate locating the position of the corner:

G-1 NE corner Sec. 4  
1" pipe with brass cap  
15" Cedar N 29° E 21.02'  
14" Cedar S 16° E 13.68'  
10" Cedar S 66° W 14.92'  
28" Cedar N 28° W 12.76'

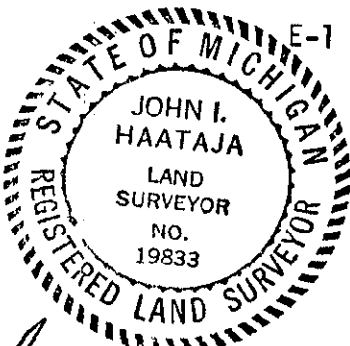

E-1 NW corner Sec. 4  
1" pipe with brass cap  
14" Cedar N 31° W 5.15'  
12" Cedar N 50° E 3.31'  
9" Maple S 60° W 11.35'  
8" Maple S 10° W 7.85'

signed by John I. Haataja  
Surveyor's Michigan License No. 19833

Date November 20, 1996