SURVEY &
REMONUMENTATION

JAN 21 1998

SECTION

LAND CORNER RECORDATION CERTIFICATE

Filing Requirement of Act 74, Mich. P.A. 1970

For corners in
Keweenaw
(County)

	Located In:	Corner Code #
1. Public Land Survey	T 58N R 29W	H-11
	T 58N R 29W	G-11 ✓
	T ___ R ___	
	T ___ R ___	
2. Property Controlling in Section	S ___ T ___ R ___	
	S ___ T ___ R ___	
3. Miscellaneous Property in Sec.	S ___ T ___ R ___	
	S ___ T ___ R ___	

REGISTER'S OFFICE
County of Keweenaw } SS
Received for Record the 30th
day of December A.D. 19 97
at 10:00 o'clock AM, and Recorded
in Liber 1 of LCR
on page 179
Julie Carlson Deputy
Register of Deeds

Register of Deeds Stamp & File Number

4. Lot No. _____, Recorded Plat _____
5. Private Claims _____

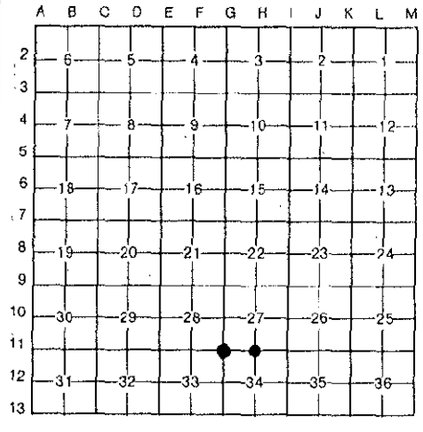

I, John Haataja, *in a field survey on* 11/14, 19 97, do hereby certify that under requirements of P.A. 74, Michigan P.A. of 1970, the corner points mentioned *in lines 1 and 2 above were in conformance with regulations and rules therefore* as required in the current manual of survey instructions of the United States Department of the Interior, Bureau of Land *Management or by a decree of a Court of Law and/or that the corner points mentioned in lines 3, 4 and 5* above were in conformance with the rules of the Michigan Board of Land Surveyors or by a Decree of a *Court of Law; established, re-established,* monumented, re-monumented, recovered, found as expressed below:

NOTE: Not more than 4 corners, all in the same town and range, may be recorded on this certificate.

A. Description of original monument and accessories and/or subsequent restoration:

H-11 Wood post.
W. Pine 12" S20°W 14 LKS
Cedar 14" N35°E 18LKS

G-11 Wood post
Fir 14" N20°E 27 LKS
Hemlock 18" S30°W 41 LKS

B. Description of corner evidence found and/or method applied in restoring or reestablishing corner:

H-11 Found a square cedar tree with tag. Reestablished corner at proportional distance between adjancent section corners.

G-11 Section corner was reestablished in 1990. In 1954 records show that corner was 3/4" pin in road, 34 LKS South of tag in 4" Hard Maple. A R.R. spike was set in road 34 LKS South of tag in 6" Hard Maple. Recorded in LCR 1, Page 102 Keweenaw County Records.

Ratified by Peer Group
In accordance with P.A. 345
Co. Rep. [signature]
Date 10/15/97

C. Description of monument for corner and accessories established to perpetuate locating the position of the corner:

H-11
Set 1" pipe with brass cap
13" Cedar S08°W 45.91'
14" Cedar S50°W 33.08'
18" Cedar N144°W 7.61'
12" W. Birch S44°E 18.90'

G-11
Set 1" pipe with brass cap in monument box.
8" Hard Maple N12°W 22.77'
6" Hard Maple N49°E 53.39'
14" Hard Maple S07°E 51.52'
12" Cedar S13°W 70.04'

STATE OF MICHIGAN
JOHN J. HAATAJA
LAND SURVEYOR
NO. 19833
REGISTERED LAND SURVEYOR

Signed by [signature] Date 12/30/1997
Surveyor's Michigan License No. 19833

FORM APPROVED BY MICHIGAN STATE BOARD OF LAND SURVEYORS, JAN. 28, 1971
REVISED MAY 14, 1975
REVISED JAN., 1983