

**SURVEY &
REMONUMENTATION**

JAN 21 1998

SECTION

**LAND CORNER RECORDATION CERTIFICATE
Filing Requirement of Act 74, Mich. P.A. 1970**

For corners in

Keweenaw

(County)

Located In:

Corner Code #

1. Public Land Survey

T 58N R 29W
T 58N R 29W
T _____ R _____
T _____ R _____
T _____ R _____

H-11 ✓
G-11

2. Property Controlling in Section

S _____ T _____ R _____
S _____ T _____ R _____

3. Miscellaneous Property in Sec.

S _____ T _____ R _____
S _____ T _____ R _____

4. Lot No. _____, Recorded Plat _____

5. Private Claims _____

REGISTER'S OFFICE

County of Keweenaw } SS

Received for Record the 30th

day of December A.D. 1997

at 10:00 o'clock A.M. and Recorded

in Liber 179 of LCR

on page _____

Julie Carlsson, Deputy
Register of Deeds

Register of Deeds Stamp & File Number

I, John Haataja, in a field survey on 11/14, 1997

do hereby certify that under requirements of P.A. 74, Michigan P.A. of 1970, the corner points mentioned in lines 1 and 2 above were in conformance with regulations and rules therefore as required in the current manual of survey instructions of the United States Department of the Interior, Bureau of Land Management or by a decree of a Court of Law and/or that the corner points mentioned in lines 3, 4 and 5 above were in conformance with the rules of the Michigan Board of Land Surveyors or by a Decree of a Court of Law; established, re-established, monumented, re-monumented, recovered, found as expressed below:

NOTE: Not more than 4 corners, all in the same town and range, may be recorded on this certificate.

A. Description of original monument and accessories and/or subsequent restoration:

H-11 Wood post.
W. Pine 12" S20°W 14 LKS
Cedar 14" N35°E 18LKS

G-11 Wood post
Fir 14" N20°E 27 LKS
Hemlock 18" S30°W 41 LKS

B. Description of corner evidence found and/or method applied in restoring or reestablishing corner:

H-11 Found a square cedar tree with tag. Reestablished corner at proportional distance between adjacent section corners.

G-11 Section corner was reestablished in 1990. In 1954 records show that corner was 3/4" pin in road, 34 LKS South of tag in 4" Hard Maple. A R.R. spike was set in road 34 LKS South of tag in 6" Hard Maple. Recorded in LCR 1, Page 102 Keweenaw County Records.

C. Description of monument for corner and accessories established to perpetuate locating the position of the corner:


H-11
Set 1" pipe with brass cap
13" Cedar S08°W 45.91'
14" Cedar S50°W 33.08'
18" Cedar N144°W 7.61'
12" W. Birch S44°E 18.90'

G-11
Set 1" pipe with brass cap in monument box.
8" Hard Maple N12°W 22.77'
6" Hard Maple N49°E 53.39'
14" Hard Maple S07°E 51.52'
12" Cedar S13°W 70.04'

Ratified by Peer Group
In accordance with P.A. 345

Co. Rep. [Signature]

Date 10/15/97

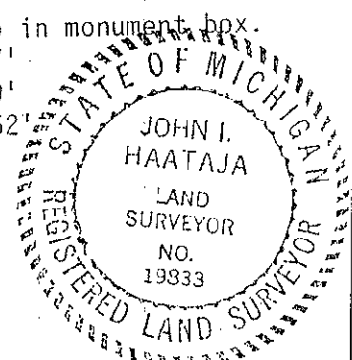

Signed by

[Signature]

Date

12/30/1997

Surveyor's Michigan License No. 19833

