

LAND CORNER RECORDATION CERTIFICATE

Filing Requirement of Act 74, Mich. P.A. 1970 (REGISTER'S OFFICE)

For corners in

Keweenaw

(County)

Located In:

Corner Code ##

1. Public Land Survey	T	58	R	29	I-2 ✓
	T	58	R	29	I-3
	T		R		
	T		R		
2. Property Controlling in Section	S		T	R	
	S		T	R	
3. Miscellaneous Property in Sec.	S		T	R	
	S		T	R	

County of Keweenaw } SS
 Received for Record, the 9th day of December A.D. 1996 at 1:00 o'clock P. M., and Recorded in Liber 1 of LCR on page 150
Roberta Rosenberger, Deputy
 Register of Deeds

Register of Deeds Stamp & File Number

4. Lot No. _____, Recorded Plat _____

5. Private Claims _____

	A	B	C	D	E	F	G	H	I	J	K	L	M
2	6	5	4	3	2								
3													
4	7	8	9	10	11	12							
5													
6	18	17	16	15	14	13							
7													
8	19	20	21	22	23	24							
9													
10	30	29	28	27	26	25							
11													
12	31	32	33	34	35	36							
13													

I, John I. Haataja in a field survey on September 20, 1996, do hereby certify that under requirements of P.A. 74, Michigan P.A. of 1970, the corner points mentioned in lines 1 and 2 above were in conformance with regulations and rules therefore as required in the current manual of survey instructions of the United States Department of the Interior, Bureau of Land Management or by a decree of a Court of Law and/or that the corner points mentioned in lines 3, 4 and 5 above were in conformance with the rules of the Michigan Board of Land Surveyors or by a Decree of a Court of Law; established, re-established, monumented, re-monumented, recovered, found as expressed below:

NOTE: Not more than 4 corners, all in the same town and range, may be recorded on this certificate.

A. Description of original monument and accessories and/or subsequent restoration:

I-2 East 1/4 corner Sec. 3
 Wood Post
 Pine 7" N 60 E 13 lks.
 Spruce 9" S 50 W 42 lks.

I-3 S.E. corner Sec. 3
 Wood Post
 Sugar 16" S 40 E 60 lks.
 Pine 14" N 34 W 15 lks.

Description of corner evidence found and/or method applied in restoring or reestablishing corner:


I-2 FND 1 1/4" pipe, corner checks to be N 15 E 67.08' of correct location by single proportionate measurement between N.E. & S.E. corners. Removed 1 1/4" pipe and set 1" pipe with brass cap at correct location.

I-3 FND 1 1/4" pipe in place. As FND in Liber 1 of L.C.R. Page 46.

Ratified by Peer Group
 In accordance with P.A. 345
 Co. Rep. John I. Haataja
 Date 12/6/96

Description of monument for corner and accessories established to perpetuate locating the position of the corner:

I-2 East 1/4 corner Sec. 3
 1" pipe with brass cap
 10" Oak S 46 W 17.48'
 12" Oak N 10 E 22.76'
 5" Maple N 74 E 15.28'
 4" W. Pine S 34 E 41.35'

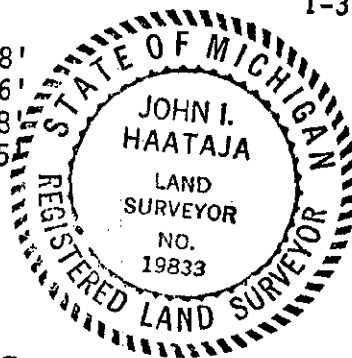

I-3 S.E. corner Sec. 3
 1 1/4" pipe with brass cap
 10" Oak S 15 E 26.88'
 10" Maple N 82 E 26.30'
 4" Maple N 7 E 6.41'
 10" Cedar S 69 W 29.08'

ed by John I. Haataja
 Surveyor's Michigan License No. 19833

Date 11/27/96