

SURVEY & REMONUMENTATION

MAR 19 1997

COMMISSION

LAND CORNER RECORDATION CERTIFICATE

Filing Requirement of Act 74, Mich. P.A. 1970

For corners in

<u>Keweenaw</u> <small>(County)</small>	Located In:	Corner Code #:	
1. Public Land Survey	T <u>58</u> R <u>29</u>	<u>I-4</u> ✓	
	T <u>58</u> R <u>29</u>	<u>I-5</u>	
	T _____ R _____		
	T _____ R _____		
2. Property Controlling in Section	S _____ T _____ R _____		
	S _____ T _____ R _____		
3. Miscellaneous Property in Sec.	S _____ T _____ R _____		
	S _____ T _____ R _____		
4. Lot No. _____, Recorded Plat _____			
5. Private Claims _____			

REGISTER'S OFFICE }
County of Keweenaw } SS
Received for Record, the 9th
day of December A.D. 1996
at 1:00 o'clock P.M., and Recorded
in Liber 1 of L.C.R.
on page 156
Roberta Rosenberger Dep.
Register of Deeds

Register of Deeds Stamp & File Number

I, John I. Haataja, in a field survey on September 5, 1996, do hereby certify that under requirements of P.A. 74, Michigan P.A. of 1970, the corner points mentioned in lines 1 and 2 above were in conformance with regulations and rules therefore as required in the current manual of survey instructions of the United States Department of the Interior, Bureau of Land Management or by a decree of a Court of Law and/or that the corner points mentioned in lines 3, 4 and 5 above were in conformance with the rules of the Michigan Board of Land Surveyors or by a Decree of a Court of Law; established, re-established, monumented, re-monumented, recovered, found as expressed below:

NOTE: Not more than 4 corners, all in the same town and range, may be recorded on this certificate.

	A	B	C	D	E	F	G	H	I	J	K	L
2	6	5	4	3	2	1						
3												
4	7	8	9	10	11							
5												
6	18	17	16	15	14	13						
7												
8	19	20	21	22	23	24						
9												
10	30	29	28	27	26	25						
11												
12	31	32	33	34	35	36						
13												

A. Description of original monument and accessories and/or subsequent restoration:


I-4 East 1/4 corner Section 10
Wood Post
Corner set 20 lks. North of Bay of Lake
Cedar 14" N 20 E 14 lks.
Cedar 6" N 10 lks.

I-5 S.E. corner Sec. 10
Wood Post
Ironwood 8" S 40 E 64 lks.
Sugar 16" S 80 W 41 lks.

B. Description of corner evidence found and/or method applied in restoring or reestablishing corner:

I-4 Orig. corner not found.
Corner location was re-established during survey of Assessor's Plat of Lake Medora as recorded in Liber _____ of L.C.R. Page 48.

I-5 Found 1-3/4" pipe in place.
As recorded in Liber 1 of L.C.R. Page 46.

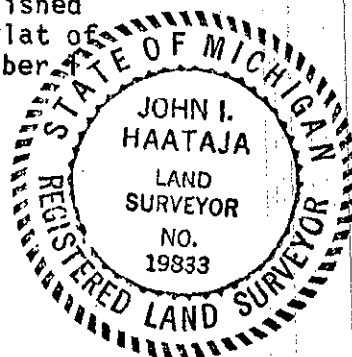

Ratified by Peer Group
In accordance with P.A. 345
Co. Rep. James M. Leubke
Date 12/6/96

C. Description of monument for corner and accessories established to perpetuate locating the position of the corner:

I-4 East 1/4 corner Sec. 10
Because 1/4 corner would be 2'± into Bay, a Wit. corner was set on meander line of plat and 27.47' N. of 1/4 cor. location W.C. 1" pipe with brass cap flush.
Ref. for W.C. Conc. Mon. N 42 W 104.75'
Conc. Mon. S 42 E 14.70'
S.E. cor. cabin N 24 E 17.33'
10" Maple N 84 W 33.79'

I-5 S.E. corner Sec. 10
1-3/4" pipe with brass cap
14" Maple N 40 W 20.48'
12" Maple S 53 W 26.51'
14" Maple S 11 E 14.09'
10" Oak N 73 E 22.26'

Signed by John I. Haataja

Date 1/27/96

Surveyor's Michigan License No. 19833