

JAN 05 2000

SECTION

LAND CORNER RECORDATION CERTIFICATE
Filing Requirement of Act 74, Mich. P.A. 1970

For corners in

Keweenaw
(County)

Located In:	Corner Code #
T <u>58</u> R <u>31</u>	<u>J-5</u>
T ___ R ___	_____
T ___ R ___	_____
T ___ R ___	_____
S ___ T ___	_____
S ___ T ___	_____
S ___ T ___	_____
S ___ T ___	_____

- 1. Public Land Survey
- 2. Property Controlling in Section
- 3. Miscellaneous Property in Sec.

REGISTER'S OFFICE }
 County of Keweenaw } SS
 Received for Record, the 13th
 day of December A.D. 19 99
 at 1:00 o'clock P.M., and Recorded
 in Liber 1 of LCR
 on page 211
James Carlisle, Deputy
 Register of Deeds

Register of Deeds Stamp & File Number

4. Lot No. _____, Recorded Plat _____
 5. Private Claims _____

I, James M. Pardini, in a field survey on 9/23, 1999 do hereby state that under requirements of P.A. 74, Michigan P.A. of 1970, the corner points mentioned in lines 1 and 2 above were in conformance with regulations and rules therefore as required in the current manual of survey instructions of the United States Department of the Interior, Bureau of Land Management or by a decree of a Court of Law and/or that the corner points mentioned in lines 3, 4 and 5 above were in conformance with the rules of the Michigan Board of Land Surveyors or by a Decree of a Court of Law; established, re-established, monumented, recovered, found as expressed below:

NOTE: Not more than 2 corners, all in the same town and range, may be recorded on this certificate.


	A	B	C	D	E	F	G	H	I	J	K	L	M
1													
2	6		5		4		3		2		1		
3													
4	7		8		9		10		11		12		
5													
6	10		17		16		15		14		13		
7													
8	19		20		21		22		23		24		
9													
10	30		29		28		27		26		25		
11													
12	31		32		33		34		35		36		
13													

A. Description of original monument and accessories and/or subsequent restoration:
 (J-5) N $\frac{1}{2}$ " corner section 14 T58N-R31W. Quarter section post set by L.S. Scranton in 1845.
 U.S. Bearing Trees:
 6" Aspen S11°E 20 lks
 9" White Birch N23°W 6 lks

B. Description of corner evidence found and/or method applied in restoring or reestablishing corner:
 (J-5) LCRC (Liber 1, page 109) recorded by John Haataja in 1993 called for 3/4" iron pin established by proportionate measure between corners East and West.

Ratified by Peer Group
 In accordance with P.A. 345
 Co. Rep. James M. Pardini
 Date 12/7/99

C. Description of monument for corner and accessories established to perpetuate locating the position of the corner:
 (J-5) Found and accepted 3/4" ironpin set 1"x30" iron pipe over 3/4" iron pipe with 4" brass cap marked Keweenaw Co. Remonumentation Point. 12" above ground.
 8" Cedar S08°E 31.76'
 4" Balsam Fir S73°W 10.34'
 10" Spruce N17°E 11.18'
 12" Spruce S75°E 23.90'

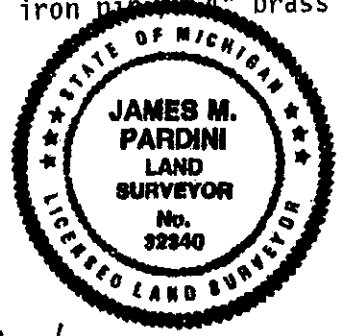

Signed by James M. Pardini
 Surveyor's Michigan License No. 32340

Date 12/7/99