

JAN 05 2000

SECTION

LAND CORNER RECORDATION CERTIFICATE
Filing Requirement of Act 74, Mich. P.A. 1970

For corners in

Keweenaw

(County)

Located In:

Corner Code #

1. Public Land Survey

T 58R 31

I-5

T 58R 31

K-5

T R

T R

S T R

S T R

S T R

S T R

2. Property Controlling in Section

3. Miscellaneous Property in Sec.

4. Lot No. Recorded Plat

5. Private Claims

REGISTER'S OFFICE

County of Keweenaw } SS

Received for Record, the 13th

day of December A.D. 1999

at 1:00 o'clock P.M., and Recorded

in Liber 1 of LCR

on page 212

James Carlson, Deputy

Register of Deeds

Register of Deeds Stamp & File Number

I, James M. Pardini, in a field survey on 9/21, 1999 do hereby state that under requirements of P.A. 74, Michigan P.A. of 1970, the corner points mentioned in lines 1 and 2 above were in conformance with regulations and rules therefore as required in the current manual of survey instructions of the United States Department of the Interior, Bureau of Land Management or by a decree of a Court of Law and for that the corner points mentioned in lines 3, 4 and 5 above were in conformance with the rules of the Michigan Board of Land Surveyors or by a Decree of a Court of Law; established, re-established, monumented, recovered, found as expressed below.

NOTE: Not more than 2 corners, all in the same town and range, may be recorded on this certificate.

Grid table with columns A-M and rows 1-13. Contains numerical data and two black dots in the grid.

A. Description of original monument and accessories and/or subsequent restoration: (I-5) NE corner section 15 T58N-R31W. Section post set by L.S. Scranton in 1845. U.S. Bearing Trees: 9" Aspen S46°W 16 lks, 10" Aspen N72°E 18 lks

(K-5) NE corner section 14 T58N-R31W Section corner post set by L.S. Scranton in 1845. U.S. Bearing Trees: 14" Cedar S47°E 13 lks, 10" Cedar N18°W 4 lks

B. Description of corner evidence found and/or method applied in restoring or reestablishing corner: (I-5) LCRC (Liber 1, page 109) recorded by John Haataja in 1993 called for 1/2" pin in rock established by proportionate measure and at record dist. North of monument found at SW corner of Park.

6" White Birch N78°W 6.35' (down)
14" White Birch N24°W 14.52'
10" Cedar S56°E 23.17'
10" Spruce S26°W 29.11'

(K-5) LCRC (Liber 1, page 10) recorded by John Haataja in 1993 found and accepted 2 1/2" iron pipe /w cap 2' above ground and /w tag on tree.

C. Description of monument for corner and accessories established to perpetuate locating the position of the corner:

(I-5) Found and accepted 1/2" pin /w 1"x18" iron pipe set in concrete /w 4" brass cap marked Keweenaw Co. Remonumentation Point set flush /w ground.


12" White Pine N54°E 19.83'
10" Cedar S54°E 23.21'
8" White Pine S74°W 13.39'
15" White Pine N28°W 14.40'

(K-5) Found and accepted 2 1/2" iron pipe. Replaced /w 1"x36" iron pipe /w 4" brass cap marked Keweenaw Co. Remonumentation Point. 18" in ground /w rock mound.

8" Cedar N34°W 22.57' 5" Sugar Maple N89°W
8" Cedar N22°E 21.18'
16" Cedar S25°W 10.98' /w tag

Signed by James M. Pardini
Surveyor's Michigan License No. 32340

Date 12/7/99

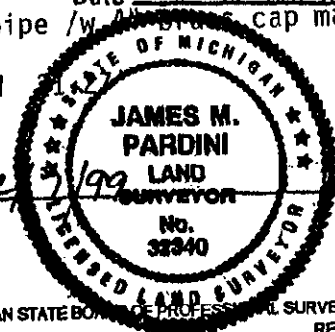

Ratified by Peer Group
In accordance with P.A. 345
Co. Rep. James M. Pardini
Date 12/7/99