

SURVEY & REMONUMENTATION

FEB 07 2001

SECTION

LAND CORNER RECORDATION CERTIFICATE
Filing Requirement of Act 74, Mich. P.A. 1970

For corners in

KEWEENAW
(County)


Located In:

Corner Code #

- | | | |
|---------------------------------------|---------------------------|---------------|
| 1. Public Land Survey | T <u>59N</u> R <u>28W</u> | <u>B-13</u> ✓ |
| | T <u>58N</u> R <u>28W</u> | <u>B-1</u> |
| | T _____ R _____ | _____ |
| | T _____ R _____ | _____ |
| 2. Property Controlling in Section | S _____ T _____ R _____ | _____ |
| | S _____ T _____ R _____ | _____ |
| 3. Miscellaneous Property in Section | S _____ T _____ R _____ | _____ |
| | S _____ T _____ R _____ | _____ |
| 4. Lot No. _____, Recorded Plat _____ | | |
| 5. Private Claims _____ | | |

REGISTER'S OFFICE }
 County of Keweenaw } SS
 Received for Record, the 7th
 day of December A.D. 2000
 at 10:30 o'clock A M., and Recorded
 in Liber 2 of LCR
 on page 7
Julie A. Carlson, Deputy
 Register of Deeds

Register of Deeds Stamp & File Number

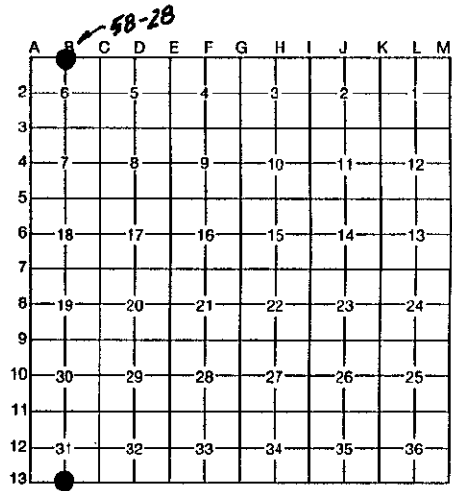


I, R. W. CRAMPTON, in a field survey on November 2000, ~~19~~
do hereby certify that under requirements of P.A. 74, Michigan P.A. of 1970, the corner points mentioned in lines 1 and 2 above were in conformance with regulations and rules therefore as required in the current manual of survey instructions of the United States Department of the Interior, Bureau of Land Management or by a decree of a Court of Law and/or that the corner points mentioned in lines 3, 4 and 5 above were in conformance with the rules of the Michigan Board of Professional Surveyors or by a Decree of a Court of Law; established, re-established, monumented, re-monumented, recovered, found as expressed below:

NOTE: Not more than 4 corners, all in the same town and range, may be recorded on this certificate.

A. Description of original monument and accessories and/or subsequent restoration:

B-13: Post; Cedar 8" N21°E 27 links, Sugar 8" N80°W 33 links (no evidence found).

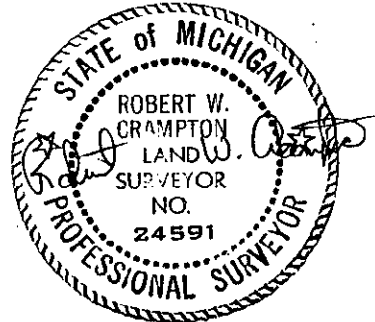

B. Description of corner evidence found and/or method applied in restoring or reestablishing corner:

B-13: Found 1" steel pin in 2'x2' square concrete pad, the position of which was in agreement with historical perpetuation of this corner. Monument accepted as found (see LCRC filed in Liber 1, P.17 on 02/03/82).

Ratified by Peer Group
 In accordance with P.A. 345
 Co. Rep. [Signature]
 Date 12/02/00

C. Description of monument for corner and accessories established to perpetuate locating the position of the corner:

B-13: Found 1" steel pin capped with a 4" diameter Keweenaw County Remonumentation Point brass cap and witnessed with a survey tag, stamped PS 24591, nailed to: 12" Pine tree N05°W 12.16 feet, 14" Pine tree N80°E 30.43 feet, 15" Oak tree S05°W 42.82 feet, 14" Pine tree S20°W 35.96 feet. Edge of 20 foot wide bituminous Mountain Lodge road lies S40°W 3.50 feet.

Signed by Robert W. Crampton
 Surveyor's Michigan License No. 24591

Date Dec. 1, 2000