

SURVEY & REMONUMENTATION

FEB 07 2001

LAND CORNER RECORDATION CERTIFICATE

Filing Requirement of Act 74, Mich. P.A. 1970

For corners in SECTION
KEWEENAW
(County)

Located In:

Corner Code #

REGISTER'S OFFICE

County of Keweenaw } SS

Received for Record, the 7th

day of December A.D. 2000

at 10:30 o'clock A M., and Recr:

in Liber 2 of LCR

on page 8

Julie A. Carlson, Deputy
Register of

Register of Deeds Stamp & File Number

- | | | |
|---------------------------------------|---------------------------|---------------|
| 1. Public Land Survey | T <u>59N</u> R <u>28W</u> | <u>C-12</u> ✓ |
| | T <u>59N</u> R <u>28W</u> | <u>C-13</u> |
| | T <u>58N</u> R <u>28W</u> | <u>C-1</u> |
| | T _____ R _____ | _____ |
| 2. Property Controlling in Section | S _____ T _____ R _____ | _____ |
| | S _____ T _____ R _____ | _____ |
| 3. Miscellaneous Property In Section | S _____ T _____ R _____ | _____ |
| | S _____ T _____ R _____ | _____ |
| 4. Lot No. _____, Recorded Plat _____ | | |
| 5. Private Claims _____ | | |

98-28

| | | | | | | | | | | | | | |
|----|----|---|----|----|---|----|---|----|---|----|---|---|---|
| | A | B | C | D | E | F | G | H | I | J | K | L | M |
| 2 | 6 | | 5 | 4 | | 3 | | 2 | | 1 | | | |
| 3 | | | | | | | | | | | | | |
| 4 | 7 | | 8 | 9 | | 10 | | 11 | | 12 | | | |
| 5 | | | | | | | | | | | | | |
| 6 | 18 | | 17 | 16 | | 15 | | 14 | | 13 | | | |
| 7 | | | | | | | | | | | | | |
| 8 | 19 | | 20 | 21 | | 22 | | 23 | | 24 | | | |
| 9 | | | | | | | | | | | | | |
| 10 | 30 | | 29 | 28 | | 27 | | 26 | | 25 | | | |
| 11 | | | | | | | | | | | | | |
| 12 | 31 | | 32 | 33 | | 34 | | 35 | | 36 | | | |
| 13 | | | | | | | | | | | | | |


I, R. W. CRAMPTON, in a field survey on November 2000, ~~19~~
do hereby certify that under requirements of P.A. 74, Michigan P.A. of 1970, the corner points mentioned in lines 1 and 2 above were in conformance with regulations and rules therefore as required in the current manual of survey instructions of the United States Department of the Interior, Bureau of Land Management or by a decree of a Court of Law and/or that the corner points mentioned in lines 3, 4 and 5 above were in conformance with the rules of the Michigan Board of Professional Surveyors or by a Decree of a Court of Law; established, re-established, monumented, re-monumented, recovered, found as expressed below:

NOTE: Not more than 4 corners, all in the same town and range, may be recorded on this certificate.

A. Description of original monument and accessories and/or subsequent restoration:

C-12: Post; W. Birch 9" S47°W 17 links, W. Birch 6" N76°E 21 links (no evidence found).

C-13: Post; Aspen 8" N52°E 24 links, Aspen 6" N69°W 24 links (no evidence found).

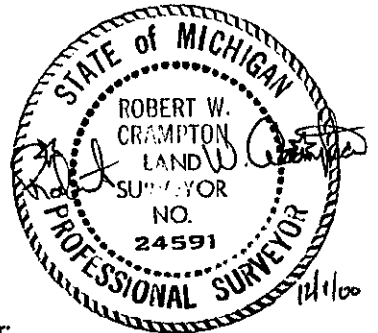

B. Description of corner evidence found and/or method applied in restoring or reestablishing corner:

C-12: Found 1" steel pin in concrete, the position of which was in agreement with historical perpetuation of this corner. Monument accepted as found (see LCRC filed in Liber 1, P.16 on 02/03/82).

C-13: Found 1" steel pin in 2'x2' square concrete pad with Sections 31 & 32 T59N, R28W and Sections 5 & 6, T58N, R28W written in the concrete. Old red blaze lines found running West and South of corner position. Monument accepted as found.

Ratified by Peer Group
In accordance with P.A. 345
Co. Rep. [Signature]
Date 12/04/00

C. Description of monument for corner and accessories established to perpetuate locating the position of the corner:

C-12: Found 1" steel pin capped with a 4" diameter Keweenaw County Remonumentation Point brass cap and witnessed with a survey tag, stamped PS 24591, nailed to: 9" White Birch tree N26°W 20.44 feet, 10" White Birch tree S76°E 3.56 feet, 8" Maple tree S21°W 14.68 feet, twin 4" Maple tree S87°W 22.27 feet.

C-13: Found 1" steel pin capped with a 4" diameter Keweenaw County Remonumentation Point brass cap and witnessed with a survey tag, stamped PS 24591, nailed to: 8" Birch tree N05°E 18.48 feet, 5" Maple tree N60°E 22.98 feet, 14" Pine tree S25°E 24.13 feet, 12" Pine tree S30°W 12.24 feet.

Signed by R. W. Crampton
Surveyor's Michigan License No. 24591

Date Dec. 1, 2000