

MAY 16 1996

COMMISSION

LAND CORNER RECORDATION CERTIFICATE
Filing Requirement of Act 74, Mich. P.A. 1970

For corners in Kalamazoo (County) Ross Twp.

Located In:

Corner Code #


- 1. Public Land Survey T 1 S, R 9 W. B-11
2. Property Controlling in Section S T R
3. Miscellaneous Property in Section S T R

Register of Deeds Stamp & File Number. Includes date 96 MAR 25 PM 3 30 and file number 1 1462.

- 4. Lot No. Recorded Plat
5. Private Claims

I, Robert E. Snell, in a field survey on February 6, 1996, do hereby certify that under requirements of P.A. 74, Michigan P.A. of 1970, the corner points mentioned in lines 1 and 2 above were in conformance with regulations and rules therefore as required in the current manual of survey instructions of the United States Department of the Interior, Bureau of Land Management or by a decree of a Court of Law and/or that the corner points mentioned in lines 3, 4 and 5 above were in conformance with the rules of the Michigan Board of Professional Surveyors or by a Decree of a Court of Law; established, re-established, monumented, re-monumented, recovered, found as expressed below:

NOTE: Not more than 4 corners, all in the same town and range, may be recorded on this certificate.

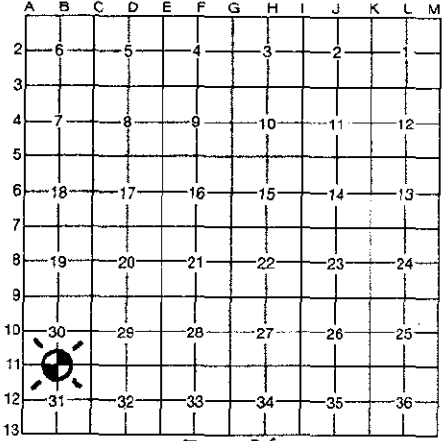

A. Description of original monument and accessories and/or subsequent restoration:

1826: United States Government Surveyors; set 1/4 Section post. Wh. Oak 16" S. 13° E. 32 lks. Wh. Oak 15" N. 14° W. 33 lks.

1883: F. Hodgman, County Surveyor; Ran N. 13° E. 32 lks. from stump of U.S. bearing tree to old stake with stone around at intersection of fences on East side of the road, set 3' of earthen post with one small stone between pieces and marked. Wh. Oak 6" N. 2 1/4° W. 30 lks. Y. Oak 6" S. 86 1/2° E. 60 lks.

B. Description of corner evidence found and/or method applied in restoring or reestablishing corner:

1939: Wilkins & Wheaton; found tile below iron above at Northeast corner of 36" Oak. Oak 30" N. 02° W. 18.48' 2 1/2' North of fence East on East side of road.

1974: John Stack, Surveyor, R.L.S. #10707; North 1/4 post Section 31, T. 1 S., R. 9 W. 1/2" iron over tile against Northeast side 48" Oak at South end of fence. Center line 24" Oak Stump N. 02°+ W. 19.58' Center line 16" Cherry S. 88° E. 67.3' Center line 8" Oak N. 20° W. 32.8'

1996: Found tile 8" below surface against Northeast side of 48" Oak, tile has been pushed to North by growing tree.

C. Description of monument for corner and accessories established to perpetuate locating the position of the corner:

B-11: South 1/4 post, Section 30, T. 1 S., R. 9 W., Ratified by the Kalamazoo County Remonumentation Program Peer Group on March 21, 1996 and is accepted is a careful and faithful perpetuation of the position of the original corner. Found 3" round tile with "x" on top as set by F. Hodgman in a Remonumentation survey in 1883. Placed Remonumentation sleeve over tile.

Table with 4 columns: Existing Nail/Tab in West side, Existing Nail/Tab in North side, PK Nail in North side, Existing Nail in West side. Values include 10" Oak N. 60° E. 30.66', 4" Sumac S. 60° E. 11.76', 48" Oak S. 60° W. 1.60' (to PK Nail), 6" Oak N. 12° W. 40.57'

Signed by Robert E. Snell

Date 3-25-96

Surveyor's Michigan License No. 9734