SURVEY &
REMONUMENTATION

FEB 18 1994

COMMISSION

STATE OF MICHIGAN
COUNTY OF KALAMAZOO
RECEIVED FOR RECORD
'94 JAN 21 AM 8 56

CLERK-REGISTER

LAND CORNER RECORDATION CERTIFICATE

Filing Requirement of Act 74, Mich. P.A. 1970

For corners in Kalamazoo (County)

	Located In:	Corner Code ##
1. Public Land Survey	T 1 S R 9 W	B-13
	T ___ R ___	
	T ___ R ___	
	T ___ R ___	
2. Property Controlling	S ___ T ___ R ___	
in Section	S ___ T ___ R ___	
3. Miscellaneous	S ___ T ___ R ___	
Property in Sec.	S ___ T ___ R ___	

LIBER 1 PG 1087

Register of Deeds Stamp & File Number

4. Lot No. _____, Recorded Plat _____
5. Private Claims _____

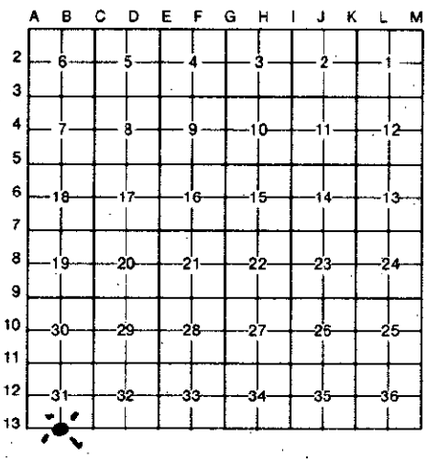

I, Robert E. Snell, in a field survey on December 13, 19 93, do hereby certify that under requirements of P.A. 74, Michigan P.A. of 1970, the corner points mentioned in lines 1 and 2 above were in conformance with regulations and rules therefore as required in the current manual of survey instructions of the United States Department of the Interior, Bureau of Land Management or by a decree of a Court of Law and/or that the corner points mentioned in lines 3, 4 and 5 above were in conformance with the rules of the Michigan Board of Land Surveyors or by a Decree of a Court of Law; established, re-established, monumented, re-monumented, recovered, found as expressed below:

NOTE: Not more than 4 corners, all in the same town and range, may be recorded on this certificate.

A. Description of original monument and accessories and/or subsequent restoration:

1825-By United States Government-Set Post

V. Oak 16" North 75°-E 78 Lks (51.48')
Hickory 7" North 52°-W 60 Lks (39.60')

1883-F. Hodgeman County Surveyor-Found stake from bearing tree North 48°-E 70 Lks (46.2')

Put in 3' Earthen Post
W. Oak 16" South 24°-E 69 1/2 Lks (45.87')

B. Description of corner evidence found and/or method applied in restoring or reestablishing corner:

Found broken and deteriorating solid clay tile in marsh-20' North of high ground.

RATIFIED
BY KALAMAZOO COUNTY
REMONUMENTATION
PEER GROUP
12/16/93

C. Description of monument for corner and accessories established to perpetuate locating the position of the corner:

B-13 South 1/4 Post Section 31, T. 1 S., R. 9 W., Ratified by Kalamazoo County Remonumentation Program Peer Group on December 16, 1993. Found solid clay tile with broken and deterioration top with takes and flaging of previous surveys. Removed deteriorating top and placed remonumentation sleeve over tile.

PK Nail in Southeast side	10" Oak	South 48°-W 48.53'
PK Nail in West side	10" Oak	South 11°-W 39.5'
PK Nail in West side	36" Oak	South 04°-W 127.13'
PK Nail in West side	20" Hickory	South 05°-E 39.92'
High Point of	2'x 3' Boulder	South 48°-30' E @ South edge of marsh

Signed by Robert E. Snell Date 1-20-94

Surveyor's Michigan License No. 9734

FORM APPROVED BY MICHIGAN STATE BOARD OF LAND SURVEYORS, JAN. 28, 1971
REVISED MAY 14, 1975
REVISED JAN., 1983