

**SURVEY &
REMONUMENTATION**

APR 27 1995

COMMISSION

LAND CORNER RECORDATION CERTIFICATE
Filing Requirement of Act 74, Mich. P.A. 1970

STATE OF MICHIGAN
COUNTY OF KALAMAZOO
RECEIVED FOR RECORD

55 JAN 17 PM 12 39

For corners in

Kalamazoo
(County)

Located In:

Corner Code #

Ross Township

1. Public Land Survey

T 1 S R 9 W

E-4

2. Property Controlling
in Section

S T R

3. Miscellaneous

S T R

Property in Sec.

S T R

4. Lot No. _____, Recorded Plat _____

5. Private Claims _____


James Jones

CLERK-REGISTER

LIBER 1 PG 1266

Register of Deeds Stamp & File Number

I, Robert E. Snell, in a field survey on October 6, 19 94, do hereby certify that under requirements of P.A. 74, Michigan P.A. of 1970, the corner points mentioned in lines 1 and 2 above were in conformance with regulations and rules therefore as required in the current manual of survey instructions of the United States Department of the Interior, Bureau of Land Management or by a decree of a Court of Law and/or that the corner points mentioned in lines 3, 4 and 5 above were in conformance with the rules of the Michigan Board of Land Surveyors or by a Decree of a Court of Law; established, re-established, monumented, re-monumented, recovered, found as expressed below:

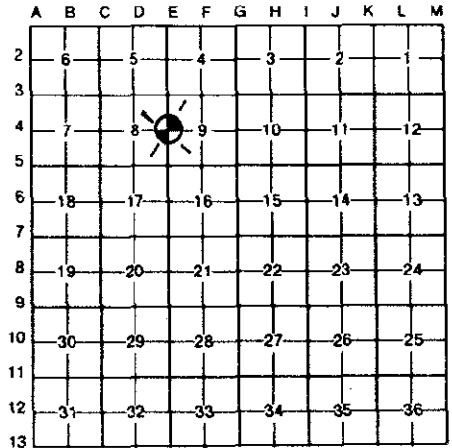

NOTE: Not more than 4 corners, all in the same town and range, may be recorded on this certificate.

A. Description of original monument and accessories and/or subsequent restoration:

1826: U.S. Government Survey; Set 1/4 Section Post.

Black Oak 36" South 62° West 20 Lks
Wh. Oak 30" North 60° East 78 Lks

1871: F. Hodgman, County Surveyor; Found stake and stone planted.

B. Oak 8" South 45° West 30 Lks
Southwest Corner of School House North 88° East 133½ Lks

1883: F. Hodgman, County Surveyor; Found stake and stone for corner and bearing tree of resurvey. See old record P.269. Bored 3'. Put stone in bottom and 2' earthen post over with stones around.
Date Unknown: State Highway; Placed 2" square iron over tile

B. Description of corner evidence found and/or method applied in restoring or reestablishing corner:

1994: Found 2" square iron over tile. Tile down 11" below surface.

**RATIFIED
BY KALAMAZOO COUNTY
REMONUMENTATION
PEER GROUP**
11/17/94 R.E.S.

C. Description of monument for corner and accessories established to perpetuate locating the position of the corner:

E-4 East 1/4 Post Section 8, T. 1 S., R. 9 W., Ratified by the Kalamazoo County Remonumentation Program Peer Group on November 17, 1994. Found 3" round tile as called for in 1883 remonumentation survey by F.Hodgman and is accepted as a careful and faithful perpetuation of the position of the original corner. Placed a remonumentation sleeve over tile with a 1/2" x 12" capped iron (#9734) over tile and a monument box over.

In Centerline of 40th Street	1/2" Iron	50.02'
PK Nail in West Side 28" Hickory	North 40° East	77.52'
PK Nail in Northwest Side 26" Pine	North 60° East	74.98'
PK Nail in North Side 16"/10" Double Spruce	East	77.30'
PK Nail in West Side 34" Oak	South 12° East	89.59'

Signed by *Robert E. Snell*

Date 1-17-95

Surveyor's Michigan License No. 9734