

**SURVEY &
REMONUMENTATION**

AUG 22 1995

COMMISSION

LAND CORNER RECORDATION CERTIFICATE
Filing Requirement of Act 74, Mich. P.A. 1970

STATE OF MICHIGAN
COUNTY OF KALAMAZOO
RECEIVED FOR RECORD

'95 AUG 1 PM 4 08

For corners in


Kalamazoo Located In: Corner Code #
(County)
Ross Township
1. Public Land Survey T 1 S R 9 W E-6
T _____ R _____
T _____ R _____
T _____ R _____
2. Property Controlling S _____ T _____ R _____
in Section S _____ T _____ R _____
3. Miscellaneous S _____ T _____ R _____
Property in Sec. S _____ T _____ R _____

Jennifer Young
CLERK-REGISTER

LIBER. **1 1316**
Register of Deeds Stamp & File Number

4. Lot No. _____, Recorded Plat _____
5. Private Claims _____

I, Robert E. Snell, in a field survey on October 6, 19 94, do hereby certify that under requirements of P.A. 74, Michigan P.A. of 1970, the corner points mentioned in lines 1 and 2 above were in conformance with regulations and rules therefore as required in the current manual of survey instructions of the United States Department of the Interior, Bureau of Land Management or by a decree of a Court of Law and/or that the corner points mentioned in lines 3, 4 and 5 above were in conformance with the rules of the Michigan Board of Land Surveyors or by a Decree of a Court of Law; established, re-established, monumented, re-monumented, recovered, found as expressed below:

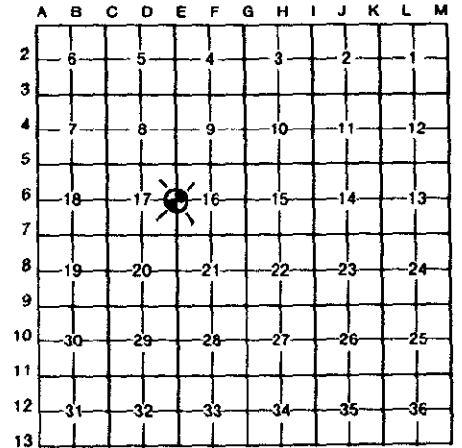

NOTE: Not more than 4 corners, all in the same town and range, may be recorded on this certificate.

A. Description of original monument and accessories and/or subsequent restoration:

1826: United States Government Survey; Set 1/4 Section Post.

Wh. Oak 7" South 25° East 157 Lks
Wh. Oak 9" South 55° West 97 Lks

1883: F. Hodgman, County Surveyor; Corner lost. I could find no sign of stake hole or evidence of witness trees. Owners of adjacent land know nothing of it. I bi-sectioned the East line of the Section and midway between Section Corners. Bored 3', put in stone in the bottom and two foot earthen post over.

Wh. Oak 10" North 16° East 148 Lks Wh. Oak 6" South 84 1/2° East 97 Lks

B. Description of corner evidence found and/or method applied in restoring or reestablishing corner:

1937: Wilkins & Wheaton Engineering; Found tile 1' West of Centerline of Pavement

30" Maple East 27.8'
12" Hickory South 50° West 33.9'
Fence to East on Line
16" Hickory North 20° West 78.0'

1973: Wilkins & Wheaton Engineering; Set Monument box.

36" Maple East 29.4'
18" Hickory South 60° West 34.3'
20" Hickory North 30° West 78.7'

1994: Found iron in monument box and tile 22" below surface. The existing monument box was over edge of tile. New monument box placed during construction of road.

RATIFIED
BY KALAMAZOO COUNTY
REMONUMENTATION
PEER GROUP
12-15-94 *R.E.S.*

C. Description of monument for corner and accessories established to perpetuate locating the position of the corner:

E-6 West 1/4 Post Section 16, T. 1 S., R. 9 W., Ratified by the Kalamazoo County Remonumentation Program Peer Group on December 15, 1994 and is accepted as a careful and faithful position of the original corner. Found 3" round tile with "X" on top, 22" below surface as called for in 1883 remonumentation survey by F.Hodgman. Placed remonumentation sleeve over tile and 20" Harrison monument over with monument box after road reconstruction over tile.

Exist. Nail/Tab in South Side	Power Pole	South 86° West 32.86'
PK Nail over recessed Nail/Tab in North Side	24" Hickory	South 54° West 34.55'
Exist. Nail/Tab in North Side	40" Maple	East 29.31'
PK Nail in North Side	16" Pine	South 32° East 60.72'
Centerline 40th Street		East 0.5'

Signed by *Robert E. Snell* Date 7-28-95
Surveyor's Michigan License No. 9734