

LAND CORNER RECORDATION CERTIFICATE
Filing Requirement of Act 74, Mich. P.A. 1970

AUG 22 1995

For corners in

Kalamazoo COMMISSION Located In:

Corner Code #

Ross Township


- | | | |
|------------------------------------|---------------------------|------------|
| 1. Public Land Survey | T <u>1</u> S R <u>9</u> W | <u>E-7</u> |
| | T _____ R _____ | _____ |
| | T _____ R _____ | _____ |
| | T _____ R _____ | _____ |
| 2. Property Controlling in Section | S _____ T _____ R _____ | _____ |
| | S _____ T _____ R _____ | _____ |
| 3. Miscellaneous Property in Sec. | S _____ T _____ R _____ | _____ |
| | S _____ T _____ R _____ | _____ |

STATE OF MICHIGAN
COUNTY OF KALAMAZOO
RECEIVED FOR RECORD
1995 JUN 6 AM 9 05
CLERK - REGISTER

Register of Deeds Stamp & File Number

4. Lot No. _____, Recorded Plat _____
5. Private Claims _____

LIBER 1 1302

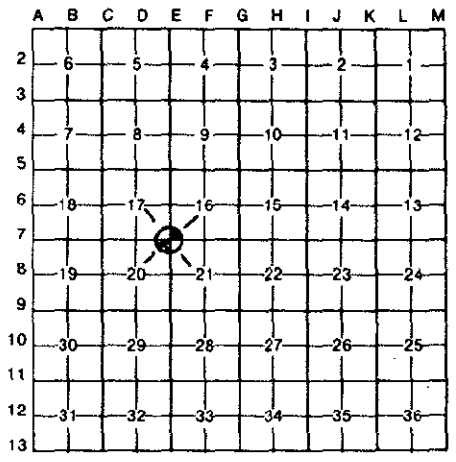

I, Robert E. Snell, in a field survey on November 8, 19 94, do hereby certify that under requirements of P.A. 74, Michigan P.A. of 1970, the corner points mentioned in lines 1 and 2 above were in conformance with regulations and rules therefore as required in the current manual of survey instructions of the United States Department of the Interior, Bureau of Land Management or by a decree of a Court of Law and/or that the corner points mentioned in lines 3, 4 and 5 above were in conformance with the rules of the Michigan Board of Land Surveyors or by a Decree of a Court of Law; established, re-established, monumented, re-monumented, recovered, found as expressed below:

NOTE: Not more than 4 corners, all in the same town and range, may be recorded on this certificate.

A. Description of original monument and accessories and/or subsequent restoration:

- 1825: United States Government Survey; Set Post, Corner to Sections 16, 17, 20 and 21.
Wh. Oak 14" South 08° West 110 Lks
Wh. Oak 18" North 40° East 61 Lks
- 1883: F. Hodgman, County Surveyor; Ran North 08° East, 110 Lks from stump of U.S. Bearing Tree to stake with stone and earthen around it. Bored 3', filled the bottom with broken earthen ware and put 2' earthen post over. Marked:
Maple 8" West 37 Lks
Maple 6" South 38° West 60 Lks

B. Description of corner evidence found and/or method applied in restoring or reestablishing corner:

- 1970: Wilkins & Wheaton Engineering Company; Found tile and placed bound.
Maple 40" South 38° West 39.6'
Maple 12" North 30° West 63.0'
Maple 14" North 60° East 71.3'
- 1994: Found iron in monument box (5/8" x 12") with 3" tile, 1' below iron.

RATIFIED
BY KALAMAZOO COUNTY
REMONUMENTATION
PEER GROUP
12-15-94

C. Description of monument for corner and accessories established to perpetuate locating the position of the corner:

- E-7 Corner to Sections 16, 17, 20 and 21, T. 1 S., R. 9 W., Ratified by the Kalamazoo County Remonumentation Program Peer Group on December 15, 1994 and is accepted as a careful and faithful perpetuation of the position of the original corner. Found 3" round tile under (5/8" x 12") iron in monument box. Removed iron and placed a 20" Harrison monument and monument box over tile.
- | | | | |
|-----------------------------------|---------------------|----------------|--------|
| Exist. 60d Nail in Southeast Side | Wood Fence Post | North 88° West | 33.17' |
| PK Nail in East Side | Maple | South 26° West | 74.90' |
| PK Nail in South Side | Power Pole | South 84° East | 85.97' |
| PK Nail in Northwest Corner | RR Tie Fence Corner | South 70° East | 34.16' |

Signed by Robert E. Snell

Date 6-5-95

Surveyor's Michigan License No. 9734