

SURVEY & REMONUMENTATION

1 AUG 06 1996

2 COMMISSION

LAND CORNER RECORDATION CERTIFICATE
Filing Requirement of Act 74, Mich. P.A. 1970

For corners in Kalamazoo (County)
Ross Township

Located In: _____ Corner Code # _____

1. Public Land Survey	T <u>1</u> S. R <u>9</u> W.	<u>F-03</u>
	T _____ R _____	_____
	T _____ R _____	_____
	T _____ R _____	_____
2. Property Controlling in Section	S _____ T _____ R _____	_____
	S _____ T _____ R _____	_____
3. Miscellaneous Property in Section	S _____ T _____ R _____	_____
	S _____ T _____ R _____	_____

4. Lot No. _____, Recorded Plat _____


5. Private Claims _____

STATE OF MICHIGAN
COUNTY OF KALAMAZOO
RECEIVED FOR RECORD
96 MAR 23 PM 1 47

James J. [Signature]
CLERK - REGISTER

LIBER 2 PAGE 006

Register of Deeds Stamp & File Number

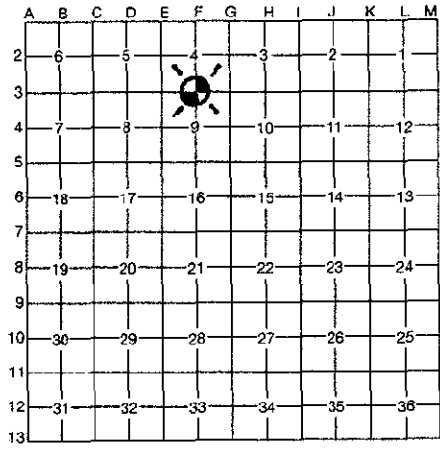

I, Robert E. Snell, in a field survey on May 1, 19 96, do hereby certify that under requirements of P.A. 74, Michigan P.A. of 1970, the corner points mentioned in lines 1 and 2 above were in conformance with regulations and rules therefore as required in the current manual of survey instructions of the United States Department of the Interior, Bureau of Land Management or by a decree of a Court of Law and/or that the corner points mentioned in lines 3, 4 and 5 above were in conformance with the rules of the Michigan Board of Professional Surveyors or by a Decree of a Court of Law; established, re-established, monumented, re-monumented, recovered, found as expressed below:

NOTE: Not more than 4 corners, all in the same town and range, may be recorded on this certificate.

A. Description of original monument and accessories and/or subsequent restoration:

1826: United States Government Surveyors; set 1/4 Section post.

Wh. Oak 20" S. 69° E. 80 lks.
Blk. Oak 18" West 71 lks.

1883: F. Hodgman, County Surveyor; found iron stake 71 lks. East of stump of U.S. bearing tree. Bored 4 ft. put iron stake in bottom with stone around and 2 foot earthen post over.

Cherry 12" N. 80 3/4° W. 139 lks.
Maple 8" N. 2° E. 34 lks.

B. Description of corner evidence found and/or method applied in restoring or reestablishing corner:

1957: Wilkins & Wheaton Engr. Co.; found 3" round tile 24" deep.

30" Maple Northeast 65.4'
in North and South fence line
Power Pole Northwest 62.0'
14" Walnut Southeast 82.20'

1996: Found 5/8" x 18" long iron bar over tile 17" deep in monument box. Reset monument box over tile.

RATIFIED
BY KALAMAZOO COUNTY
REMONUMENTATION
PEER GROUP
5-16-1996 *[Signature]*

C. Description of monument for corner and accessories established to perpetuate locating the position of the corner:

F-03: South 1/4 post Section 4, T. 1 S., R. 9 W.; Ratified by the Kalamazoo County Remonumentation Program Peer Group on May 16, 1996, and is accepted as a careful and faithful perpetuation of the position of the original corner. Found 3" round tile as set by F. Hodgman, County Surveyor in an 1883 remonumentation survey. Placed 10" Harrison Monument in concrete in monument box over tile.

PK Nail on East Side of 12" Hickory N. 58° E. 32.51'
PK Nail on West Side of 18" Pine S. 40° E. 36.15'
Nail and Tab West Side of 12" Walnut S. 14° W. 22.52'
Nail and Tab North Side of Power Pole N. 62° W. 60.88'

Signed by *Robert E. Snell* Date 5-23-96
Surveyor's Michigan License No. 9734