SURVEY & REMONUMENTATION

FEB 18 1994

COMMISSION

LAND CORNER RECORDATION CERTIFICATE

Filing Requirement of Act 74, Mich. P.A. 1970

STATE OF MICHIGAN
COUNTY OF KALAMAZOO
RECEIVED FOR RECORD
'94 JAN 21 AM 8 56

CLERK-REGISTER

LIBER 1 PG 1089

Register of Deeds Stamp & File Number

For corners in

Kalamazoo (County)

	Located In:	Corner Code ##
1. Public Land Survey	T 1 S R 9 W	F-7
	T ___ R ___	
	T ___ R ___	
	T ___ R ___	
2. Property Controlling	S ___ T ___ R ___	
in Section	S ___ T ___ R ___	
3. Miscellaneous	S ___ T ___ R ___	
Property in Sec.	S ___ T ___ R ___	

4. Lot No. _____, Recorded Plat _____
5. Private Claims _____

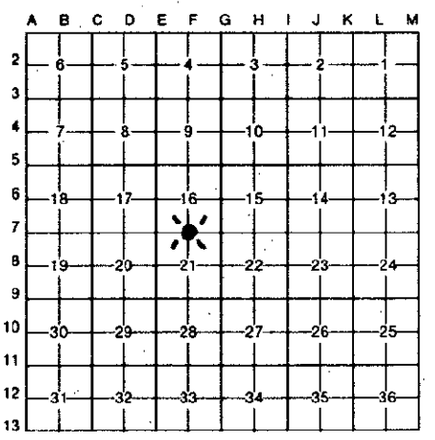

I, Robert E. Snell, in a field survey on December 13, 19 93, do hereby certify that under requirements of P.A. 74, Michigan P.A. of 1970, the corner points mentioned in lines 1 and 2 above were in conformance with regulations and rules therefore as required in the current manual of survey instructions of the United States Department of the Interior, Bureau of Land Management or by a decree of a Court of Law and/or that the corner points mentioned in lines 3, 4 and 5 above were in conformance with the rules of the Michigan Board of Land Surveyors or by a Decree of a Court of Law; established, re-established, monumented, re-monumented, recovered, found as expressed below:

NOTE: Not more than 4 corners, all in the same town and range, may be recorded on this certificate.

A. Description of original monument and accessories and/or subsequent restoration:

North 1/4 Post--Established by United State Government Survey 1826

Wh. Oak 10" South 38°-W 14 Lks
Wh. Oak 12" South 78°-E 24 Lks

1883-F.Hodgeman County Surveyor found stake standing. No witness. Bored 3' at corner post. Put stone in bottom and 2' Earthen Post over with stone around.

Wh. Oak 5" South 74°-E 4 1/2 Lks
Y. Oak 6" South 08°-W 24 Lks

B. Description of corner evidence found and/or method applied in restoring or reestablishing corner:

Original corner and accessories not recovered.
Found solid clay and accessories, one witness tree alive and one tree standing but dead.

RATIFIED
BY KALAMAZOO COUNTY
REMONUMENTATION
PEER GROUP
12/16/93

C. Description of monument for corner and accessories established to perpetuate locating the position of the corner:

F-7 North 1/4 Post Section 21, T. 1 S., R. 9 W., Ratified by Kalamazoo County Remonumentation Program Peer Group on December 16, 1993.Found solid clay tile with "X" on top and tone around as called for by 1883 Remonumentation by F. Hodgeman and is accepted as a careful and faithful perpetuation of the original corners position. Placed remonumentation sleeve over tile.

PK Nail in Southwest side	20" Maple	North 45°-W 38.96'	E & W Fence	South 1.6'
PK Nail in North side	10" Oak	North 84°-W 48.15'		
PK Nail in West side	30" Oak	South 12°'W 61.8'		
PK Nail in North side	24" Oak	South 77°-30' East 3.59'	Note this is F. Hodgeman witness tree	

Signed by Robert E. Snell Date 1-20-94

Surveyor's Michigan License No. 9734

FORM APPROVED BY MICHIGAN STATE BOARD OF LAND SURVEYORS, JAN. 28, 1971
REVISED MAY 14, 1975
REVISED JAN., 1983