LAND CORNER RECORDATION CERTIFICATE
Filing Requirement of Act 74, Mich. P.A. 1970

STATE OF MICHIGAN
COUNTY OF KALAMAZOO
RECEIVED FOR RECORD
'94 MAR 15 PM 1 37
CLERK-REGISTER

LIBER 1 PG 1107
Register of Deeds Stamp & File Number

For corners in
Kalamazoo (County)

	Located In:	Corner Code #
1. Public Land Survey	T 1 S R 9 W	G-7
	T ___ R ___	
	T ___ R ___	
	T ___ R ___	
2. Property Controlling	S ___ T ___ R ___	
in Section	S ___ T ___ R ___	
3. Miscellaneous	S ___ T ___ R ___	
Property in Sec.	S ___ T ___ R ___	

Ross Section 16

4. Lot No. _____, Recorded Plat _____
5. Private Claims _____

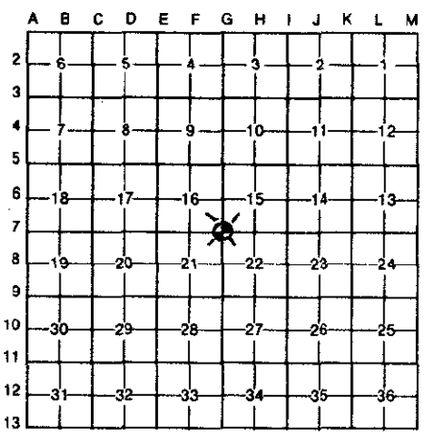

I, Robert E. Snell, in a field survey on January 3, 19 94, do hereby certify that under requirements of P.A. 74, Michigan P.A. of 1970, the corner points mentioned in lines 1 and 2 above were in conformance with regulations and rules therefore as required in the current manual of survey instructions of the United States Department of the Interior, Bureau of Land Management or by a decree of a Court of Law and/or that the corner points mentioned in lines 3, 4 and 5 above were in conformance with the rules of the Michigan Board of Land Surveyors or by a Decree of a Court of Law; established, re-established, monumented, re-monumented, recovered, found as expressed below:

NOTE: Not more than 4 corners, all in the same town and range, may be recorded on this certificate.

A. Description of original monument and accessories and/or subsequent restoration:

Original corner set by U.S. Government Survey in 1826-set post.

Tamarack 7" South 30°-E 2 Lks (1.32')
Tamarack 8" North 20°-W 6 Lks (3.96')

1887-F. Hodgeman-County Surveyor-found fence post standing at corner-both witness stumps remaining

1883-F. Hodgeman County Surveyor-removed post. Put stone in bottom and two foot earthen post over.
Tamarack 6" North 55°-E 19 Lks (12.54') Elm 16' South 19°-E 110 Lks (72.60')

B. Description of corner evidence found and/or method applied in restoring or reestablishing corner:

Found 3" clay tile with top deteriorating-found from J. Carr Witness (1974)

"T" Iron fence cor. on Southwest side of tile set as witness post.

12" Maple North 45°-E 13.16'
Twin Walnut South 80°-E 12.56'

RATIFIED
BY KALAMAZOO COUNTY
REMONUMENTATION
PEER GROUP
3-3-94

C. Description of monument for corner and accessories established to perpetuate locating the position of the corner:

G-7 Southeast Corner Section 16, T. 1 S., R. 9 W., ratified by Kalamazoo County Remonumentation Program Peer Gruop on March 3, 1994. Found 3" round tile at surface of swamp as called for in remonumentation survey of 1883 by F. Hodgeman and is accepted as a careful and faithful perpetuation of the original corners position. Placed remonumentation sleeve over tile and placed "T" Iron Fence Post on West side of tile/sleeve.

Exst Nail/Tab	in S side	14" Maple	North 60°-E	13.33'
PK Nail	in S side	16" Maple	North 70°-E	76.81'
PK Nail	in S side	12" Tamarak	South 25°-E	26.35'
PK Nail	in E side	15" Tamarak	South	46.13'
Stream from pond to East			South 68.0'±	

Signed by Robert E. Snell Date 3-15-94

Surveyor's Michigan License No. 9734

FORM APPROVED BY MICHIGAN STATE BOARD OF LAND SURVEYORS, JAN. 28, 1971
REVISED MAY 14, 1975
REVISED JAN., 1983